

MISSISSIPPI DEPARTMENT OF NATURAL RESOURCES

Bureau of Land and Water Resources

Southport Mall

P.O. Box 10631

Jackson, Mississippi 39209

WATER WELL DRILLERS LOG

PANOLA
LD 2005
11/30/81

11-30 1981
date well completed

HICKS WELL COMPANY

RT. 1 BOX 157
SENATORIA MISS.

Panola
county well located

LANDOWNER: Mt. Level Church

description of formations encountered

from

to

1/2 CL. Whiting P.O. Box 21
Came, Mo. 38619
(mailing address)

Red Clay

0

20

Red sand

20

65

Gravel

65

165

White sand

165

180

WELL LOCATION:

sec 18 T 7 N R 7 E
3 miles SW of Came
(distance) (direction) (nearest town)

WELL PURPOSE: Church
(home, irrigation, municipal, industrial)

WELL COMPLETION DATA:

- (1) diameter (inches) 4
- (2) total depth (feet) 180
- (3) static water level (feet) 100 below above top of ground.
- (4) casing PVC 180
(material) (depth)

(size) if telescope see back.

- (5) screen 12 168
(length) (depth to top)

4" gravel + PVC
(size) (material)

- (6) pump 1/2 10
(HP) (yield gpm)

220V
(type power)

- (7) electric log Yes
(yes or no)

(organization running log)

- (8) how well bottom plugged Cap

DRILLERS REMARKS:


DEPT. OF NATURAL RESOURCES
BUREAU OF LAND & WATER RESOURCES

JAN 4 - 1982

RECEIVED

If well telescopes please sketch and show depths.

GROUND LEVEL

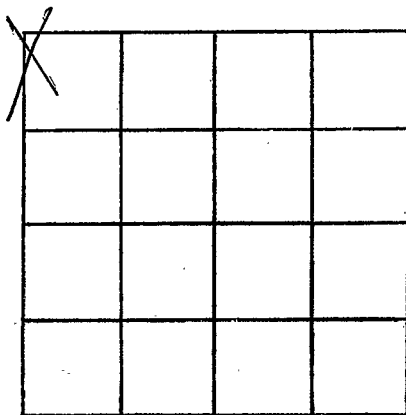

SECTION

18

Please indicate well location X.

ADDITIONAL INFORMATION

If more than one screen, show locations of each on sketch.