

MISSISSIPPI DEPARTMENT OF NATURAL RESOURCES

Bureau of Land and Water Resources

Southport Mall

P.O. Box 10631

Jackson, Mississippi 39209

WATER WELL DRILLERS LOG

Parola  
G  
2006

4-28 19 Bob Smith Parola  
 date well completed firm name county well located

LANDOWNER:  
Newt Rye  
Sardis, Miss  
 (mailing address)

description of formations encountered	from	to
<u>top soil</u>	<u>0</u>	<u>5</u>
<u>red clay</u>	<u>5</u>	<u>30</u>
<u>gravel</u>	<u>30</u>	<u>90</u>
<u>white clay</u>	<u>90</u>	<u>160</u>
<u>white sand</u>	<u>160</u>	<u>200</u>

WELL LOCATION:  
 sec. 33 T 7 N R 7 E  
4 miles W of SARDIS  
 (distance) (direction) (nearest town)

WELL PURPOSE:  
 home,  irrigation,  municipal,  industrial

WELL COMPLETION DATA:  
 (1) diameter (inches) 4"  
 (2) total depth (feet) 200'  
 (3) static water level (feet) 160'  below above top of ground.  
 (4) casing plastic 200'  
 (material) (depth)  
 \_\_\_\_\_ if telescope see back.  
 (size)  
 (5) screen 20', 180'  
 (length) (depth to top)  
4", plastic  
 (size) (material)  
 (6) pump 1/2, 10  
 (HP) (yield gpm)  
elec.  
 (type power)  
 (7) electric log  (yes, or no)  
 \_\_\_\_\_  
 (organization running log)  
 (8) how well bottom plugged cap

DEPT. OF NATURAL RESOURCES  
 BUREAU OF LAND & WATER RESOURCES


OCT 12 1982

RECEIVED

DRILLERS REMARKS:

If well telescopes please sketch and show depths.

GROUND LEVEL

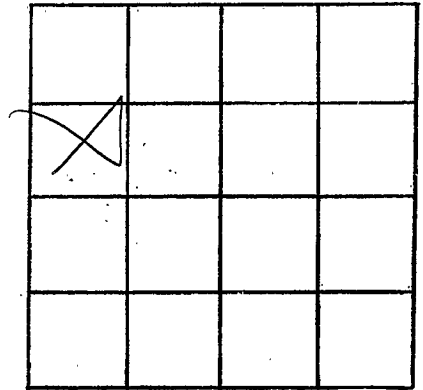

SECTION \_\_\_\_\_

Please indicate well location X.

ADDITIONAL INFORMATION

If more than one screen,  
show locations of each on sketch.