

MISSISSIPPI DEPARTMENT OF NATURAL RESOURCES
 Bureau of Land and Water Resources
 Southport Mall
 P.O. Box 10631
 Jackson, Mississippi 39209
WATER WELL DRILLERS LOG

Panola
 G
 2008

6-1 1983
 date well completed

HICKS WELL CO.

Panola
 county well located

RT. 1, *Coma*
 Complete No. 0000

LANDOWNER: <i>Marshi On</i>	description of formations encountered	from	to
<i>Rs. 2 Box 135 D</i> <i>Coma, Miss. 38619</i> (mailing address)			
WELL LOCATION: sec. <u>7</u> T. <u>7</u> N. R. <u>7</u> E. W. <u>7</u>	<i>Red Clay</i>	<i>0</i>	<i>20</i>
<u>2</u> miles <u>SW</u> of <u>Coma</u> (distance) (direction) of (nearest town)	<i>Red Sand</i>	<i>20</i>	<i>50</i>
WELL PURPOSE: <i>Home</i> (home, irrigation, municipal, industrial)	<i>Red Sand & Clay</i>	<i>50</i>	<i>75</i>
WELL COMPLETION DATA: (1) diameter (inches) <u>4</u>	<i>Gravel</i>	<i>75</i>	<i>165</i>
(2) total depth (feet) <u>180</u>	<i>White Sand</i>	<i>165</i>	<i>180</i>
(3) static water level (feet) <u>100</u> ^{below} above top of ground.			
(4) casing <u>PVC</u> , <u>180</u> , (material) (depth) <u>4</u> " (size) If telescope see back.			
(5) screen <u>15'</u> , <u>165'</u> (length) (depth to top) <u>1013</u> , <u>PVC</u> (size) (material)			
(6) pump <u>1/2</u> , <u>10</u> (HP) (yield gpm) <u>220V</u> (type power)			
(7) electric log <u>No</u> (yes or no)			
(organization running log)			
(8) how well bottom plugged <u>Cap</u>			

DEPT. OF NATURAL RESOURCES
 BUREAU OF LAND & WATER RESOURCES


JUN 27 1983

RECEIVED

DRILLERS REMARKS:

If well telescopes please sketch and show depths.

GROUND LEVEL

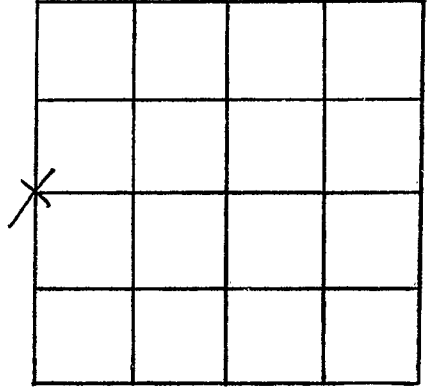

SECTION 7

Please indicate well location X.

ADDITIONAL INFORMATION

If more than one screen, show locations of each on sketch.