

MISSISSIPPI DEPARTMENT OF NATURAL RESOURCES

Bureau of Land and Water Resources

Southport Mall

P.O. Box 10631

Jackson, Mississippi 39209

WATER WELL DRILLERS LOG

Panola
G 2010

4/01/84 19 *Bullet well Drilling Panola*
date well completed firm name county well located

LANDOWNER: *Mr. Russell*
Como miss

description of formations encountered	from	to
<i>Top soil</i>	<i>0</i>	<i>3</i>
<i>red clay</i>	<i>3</i>	<i>23</i>
<i>shale and coal</i>	<i>23</i>	<i>70</i>
<i>limestone</i>	<i>70</i>	<i>75</i>
<i>sand</i>	<i>75</i>	<i>120</i>

(mailing address)

WELL LOCATION:

sec. *5* T *2* (N) R. *10* (E)
5 miles *South* of *Como*
(distance) (direction) (nearest town)

WELL PURPOSE:

(home, irrigation, municipal, industrial)

WELL COMPLETION DATA:

- (1) diameter (inches) *4"*
- (2) total depth (feet) *120'*
- (3) static water level (feet) *80* below above top of ground.
- (4) casing *PVC*, *110*,
(material) (depth)
(size) if telescope see back.
- (5) screen *10*, *110/20*
(length) (depth to top)
4", *PVC*
(size) (material)
- (6) pump *1*,
(HP) (yield gpm)
elect
(type power)
- (7) electric log *no*
(yes or no)
(organization running log)
- (8) how well bottom plugged *cap*

DEPT. OF NATURAL RESOURCES
BUREAU OF LAND & WATER RESOURCES


APR 26 1984

RECEIVED

DRILLERS REMARKS:

If well telescopes please sketch and show depths.

GROUND LEVEL

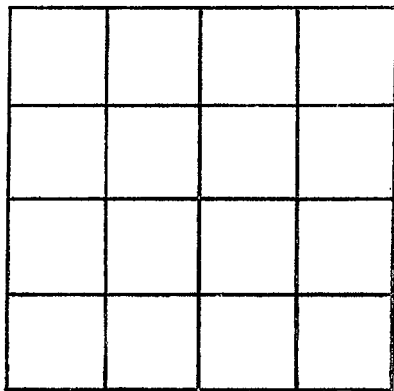

SECTION _____

Please indicate well location X.

ADDITIONAL INFORMATION

If more than one screen, show locations of each on sketch.