

PANOLA
G2011

MISSISSIPPI DEPARTMENT OF NATURAL RESOURCES
Bureau of Land and Water Resources
Southport Mall
P.O. Box 10631
Jackson, Mississippi 39209
WATER WELL DRILLERS LOG

4-3-1986 date well completed
HICKS WELL COMPANY
Rt. 1 - ~~Box name~~
Panola county well located

LANDOWNER: Mr. Jenkins
Rt # 2
Como, ms 38819
(mailing address)

description of formations encountered	from	to
Red clay	0	20
Red sand	20	30
Gravel	30	110
White sand	110	140

WELL LOCATION:
sec. 5 T. 7 N R. 7 E
S W
1 miles S of Como
(distance) (direction) (nearest town)


WELL PURPOSE: Home
(home, irrigation, municipal, industrial)

WELL COMPLETION DATA:

- (1) diameter (inches) 4"
- (2) total depth (feet) 140'
- (3) static water level (feet) 80' below above top of ground.
- (4) casing PVC, 130'
(material) (depth)
4" if telescope see back.
(size)
- (5) screen 10', 130'
(length) (depth to top)
OB, PVC
(size) (material)
- (6) pump 1/2, 10
(HP) (yield gpm)
280 V
(type power)
- (7) electric log NO
(yes or no)

(organization running log)
- (8) how well bottom plugged Cef

DRILLERS REMARKS:

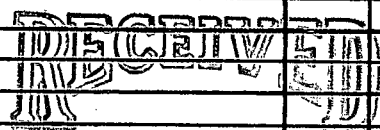


MAY 19 1986

Department of Natural Resources
Bureau of Land & Water Resources

If well telescopes please sketch and show depths.

GROUND LEVEL

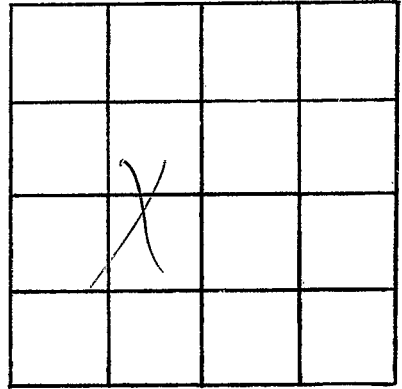

SECTION 5

Please indicate well location X.

ADDITIONAL INFORMATION

If more than one screen,
show locations of each on sketch.