

**MISSISSIPPI DEPARTMENT OF NATURAL RESOURCES**  
Bureau of Land and Water Resources

P.O. Box 10631  
Jackson, Mississippi 39209  
**WATER WELL DRILLERS LOG**

COUNTY WELL LOCATED  
*Amelia*

WELL NUMBER CODED  
*G 2017*

DATE WELL COMPLETED  
*6-21-88*

PERMIT NUMBER

NAME OF DRILLING FIRM  
**BOCK'S WELL COMPANY**  
P.O. BOX 157

NAME & MAILING ADDRESS OF LANDOWNER  
*James Harris*  
*Rt. 2*  
*Corn, Ms. 38619*

WELL LOCATION: SEC TOWNSHIP RANGE  
*8 7 N 7 E*

DISTANCE DIRECTION NEAREST TOWN  
*2* Miles *SW* of *Corn*

OTHER LANDMARK

WELL PURPOSE:  Home Irrigation,  Municipal,  Industrial,  Fish Pond, etc.

**PUMP DATA**

PUMP TYPE (Circle One):  
 Submersible,  Turbine,  Jet,  Flowing Well,  
Other (Describe) \_\_\_\_\_

POWER TYPE (Circle One):  
 Electric,  Tractor,  Diesel,  Gasoline,  Butane,  
Other (Describe) \_\_\_\_\_

Pump Capacity (GPM) <i>10</i>	No. of Stages <i>9</i>	Setting Depth <i>150</i> FT.
----------------------------------	---------------------------	---------------------------------

PUMP TEST

Well yielded \_\_\_\_\_ GPM with  
a drawdown of \_\_\_\_\_ ft.  
after \_\_\_\_\_ hours of pumping

**WELL DATA**

Well Depth <i>150</i>	Casing Diameter (In.) <i>4</i>	Casing Length (Ft.) <i>140</i>
Type of Casing <i>PVC</i>	Hole Depth <i>150</i>	Depth to Static Water Level <i>80</i>

TYPE OF COMPLETION: (Circle One or More):  
 Gravel Packed,  Underreamed,  Telescoped,  
 Natural Development,  Open Hole,  Other

Top of Lap Pipe or Reduction in Casing  
FEET  IF TELESCOPED OR MORE THAN ONE SCREEN: USE BACK PAGE

**LOG DATA**

TYPE OF LOG RUN (Circle One):  
 No Log Run,  Electric,  Gamma Ray,  Density,  Sonic,  Neutron,  
Other (Describe) \_\_\_\_\_

Name of Organization Running Log

**SCREEN DATA**

Diameter - Inches <i>4</i>	Length - Feet <i>10</i>	Slot Size - Inches <i>.013</i>
Screen Type <i>PVC</i>	Depth to Bottom - Feet <i>0</i>	

**GEOLOGIC DATA (Office Use Only)**

Surface Elev.	Geologic Unit	Unit Thickness	Depth to Top
Subs. SWL	Date	Analysis	Aquifer Test

Driller's Remarks

**RECEIVED**  
*SEP 21 1988*


DESCRIPTION OF FORMATIONS ENCOUNTERED	FROM	TO	FORMATIONS (Continued)	FROM	TO
<i>Red Clay</i>	<i>0</i>	<i>10</i>			
<i>Red Sand</i>	<i>10</i>	<i>40</i>			
<i>White Sand</i>	<i>40</i>	<i>58</i>			

IF MORE SPACE IS NEEDED, USE BACK

Department of Natural Resources  
Bureau of Land & Water Resources

If well telescopes please sketch and show depths.

GROUND LEVEL

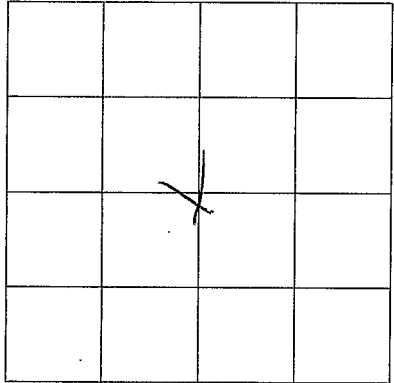

SECTION 8

Please indicate well location X.

ADDITIONAL INFORMATION

Lined area for additional information.

If more than one screen, show location of each on sketch.