

MISSISSIPPI DEPARTMENT OF NATURAL RESOURCES

Bureau of Land and Water Resources

COUNTY WELL LOCATED PANOLA	
WELL NUMBER G 2020	CODED
DATE WELL COMPLETED 5-13-90	

PERMIT NUMBER
NAME OF DRILLING FIRM HICKS WELL CO.
RT. 1 BOX 157 SENATOBIA, MS 38608

P.O. Box 10631
Jackson, Mississippi 39209
WATER WELL DRILLERS LOG

NAME & MAILING ADDRESS OF LANDOWNER Robert THOMBS			
RT. 2			
COMO, MS 38619			
WELL LOCATION: SEC	TOWNSHIP	RANGE	
6	7	N 7 E	
DISTANCE	DIRECTION	NEAREST TOWN	
3 Miles	S/E	of COMO	
OTHER LANDMARK			
WELL PURPOSE <input checked="" type="checkbox"/> Home Irrigation, Municipal, Industrial, Fish Pond, etc.			

PUMP DATA			
PUMP TYPE (Circle One): <input checked="" type="checkbox"/> Submersible Turbine, Jet Flowing Well, Other (Describe) _____			
POWER TYPE (Circle One): <input checked="" type="checkbox"/> Electric Tractor, Diesel, Gasoline, Butane, Other (Describe) _____ H/P 1/2			
Pump Capacity (GPM)	No. of Stages	Setting Depth	
10	12	160 FT.	
PUMP TEST			
Well yielded 10 GPM with a drawdown of _____ ft. after _____ hours of pumping			

WELL DATA		
Well Depth 180	Casing Diameter (In.) PVC	Casing Length (Ft.) 170
Type of Casing PVC	Hole Depth 170	Depth to Static Water Level 120
TYPE OF COMPLETION: (Circle One or More): Gravel Packed, Underreamed, Telescoped, Natural Development, Open Hole, Other (Describe) _____		
Top of Lap Pipe or Reduction in Casing		
FEET <input type="checkbox"/> IF TELESCOPED OR MORE THAN ONE SCREEN: USE BACK PAGE		

LOG DATA	
TYPE OF LOG RUN (Circle One): No Log Run, Electric, Gamma Ray, Density, Sonic, Neutron, Other (Describe) _____	
Name of Organization Running Log	

SCREEN DATA		
Diameter - Inches 4'	Length - Feet 10'	Slot Size - Inches 0.13
Screen Type PVC	Depth to Bottom - Feet 10	


GEOLOGIC DATA (Office Use Only)			
Surface Elev.	Geologic Unit	Unit Thickness	Depth to Top
Subs. SWL	Date	Analysis	Aquifer Test
Driller's Remarks			

DESCRIPTION OF FORMATIONS ENCOUNTERED	FROM	TO	FORMATIONS (Continued)	FROM	TO
RC	0	20	RECEIVED JUN 07 1990 Department of Natural Resources Bureau of Land & Water Resources		
RC + S	20	80			
WS + C	80	130			
WS	130	180			

IF MORE SPACE IS NEEDED, USE BACK

If well telescopes please
sketch and show depths.

GROUND LEVEL

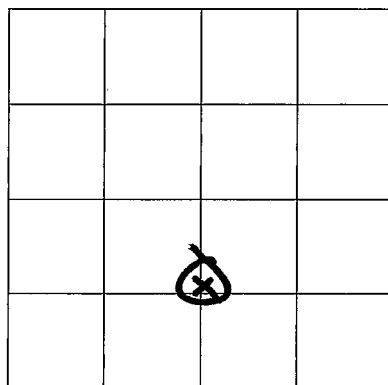

SECTION _____

Please indicate well location X.

ADDITIONAL INFORMATION

If more than one screen,
show location of each on sketch.