

MISSISSIPPI DEPARTMENT OF NATURAL RESOURCES
 Bureau of Land and Water Resources
 Southport Mall
 P.O. Box 10631
 Jackson, Mississippi 39209
WATER WELL DRILLERS LOG

PANOLA
G 222

10-7-90 date well completed LIPE WELL + Supply firm name PANOLA county well located

LANDOWNER: S. P. HENRY

SARDIS, MS. 38666
 (mailing address)

description of formations encountered	from	to
Top soil, RED clay	0	20
Red clay, SAND	20	40
SAND - PEA GRAVEL	40	60
PEA GRAVEL - GRAVEL	60	80
GRAVEL - SAND	80	100
SAND	100	132
SAND	120	132

WELL LOCATION:

sec. 34 T 7 N R 7 E

Y4 miles WEST of SARDIS
 (distance) (direction) (nearest town)

WELL PURPOSE: HOME
 (home, irrigation, municipal, industrial)

WELL COMPLETION DATA:

(1) diameter (inches) 4"

(2) total depth (feet) 132

(3) static water level (feet) 80 below above top of ground.

(4) casing PVC, 122
 (material) (depth)

4"
 (size) if telescope see back.

(5) screen 10, 122
 (length) (depth to top)

4, PVC
 (size) (material)

(6) pump 3/4, 15
 (HP) (yield gpm)

ELECTRIC
 (type power)

(7) electric log (no)
 (organization running log)

(8) how well bottom plugged CAP


RECEIVED
 AUG 15 1990

Department of Natural Resources
 Bureau of Land & Water Resources

DRILLERS REMARKS: _____

If well telescopes please sketch and show depths.

GROUND LEVEL

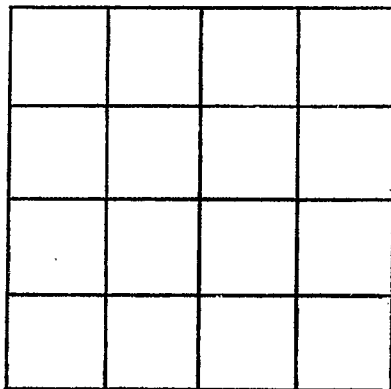

SECTION _____

Please indicate well location X.

ADDITIONAL INFORMATION

If more than one screen,
show locations of each on sketch.