

MISSISSIPPI DEPARTMENT OF ENVIRONMENTAL QUALITY
Bureau of Land and Water Resources

P. O. Box 10631
Jackson, MS 39289-0631
WATER WELL DRILLERS LOG

COUNTY WELL LOCATED
Panola

WELL NUMBER G 2023 CODED

DATE WELL COMPLETED
5-20-91

PERMIT NUMBER
HICKS WELL CO.

NAME OF DRILLING FIRM
RT. 1 BOX 157

SENATOBIA, MS 38668

NAME & MAILING ADDRESS OF LANDOWNER
Johnnie Whitt

RT 1 Box 147

Houston, MS 38851

WELL LOCATION: SEC 2 TOWNSHIP 7 RANGE 9
S N E W

DISTANCE 18 Miles DIRECTION E of NEAREST TOWN Como

OTHER LANDMARK

WELL PURPOSE: Home, Irrigation, Municipal, Industrial, Fish Pond, etc.

PUMP DATA

PUMP TYPE (Circle One):
Submersible Turbine, Jet, Flowing Well,
Other (Describe)

POWER TYPE (Circle One):
Electric Tractor, Diesel, Gasoline, Butane,
Other (Describe) H/P 2

Pump Capacity (GPM) 10 No. of Stages 9 BC Setting Depth 110 FT.

PUMP TEST

Well yielded 10 GPM with
a drawdown of _____ ft.
after _____ hours of pumping

WELL DATA

Well Depth <u>130</u>	Casing Diameter (In.) <u>4"</u>	Casing Length (Ft.) <u>120</u>
Type of Casing <u>PVC</u>	Hole-Depth <u>130</u>	Depth to Static Water Level <u>90</u>

TYPE OF COMPLETION: (Circle One or More):
Gravel Packed, Underreamed, Telescoped,
Natural Development, Open Hole, Other

Top of Lap Pipe or Reduction in Casing

FEET IF TELESCOPED OR MORE THAN ONE SCREEN: USE BACK PAGE

LOG DATA

TYPE OF LOG RUN (Circle One): No Log Run,
Electric, Gamma Ray, Density, Sonic, Neutron,
Other (Describe)

Name of Organization Running Log

SCREEN DATA

Diameter - Inches <u>4"</u>	Length - Feet <u>10'</u>	Slot Size - Inches <u>013</u>
Screen Type <u>PVC</u>	Depth to Bottom - Feet <u>10'</u>	

GEOLOGIC DATA (Office Use Only)

Surface Elev.	Geologic Unit	Unit Thickness	Depth to Top
Subs. SWL	Date	Analysis	Aquifer Test

Driller's Remarks

DESCRIPTION OF FORMATIONS ENCOUNTERED	FROM	TO	FORMATIONS (Continued)	FROM	TO
<u>Dirt</u>	<u>0</u>	<u>3</u>			
<u>clay + sand</u>	<u>3</u>	<u>80</u>			
<u>SAND</u>	<u>80</u>	<u>130</u>			

RECEIVED


JUN 24 1991

Dept. of Environmental Quality
Bureau of Land & Water Resources

IF MORE SPACE IS NEEDED, USE BACK

If well telescopes please
sketch and show depths.

GROUND LEVEL

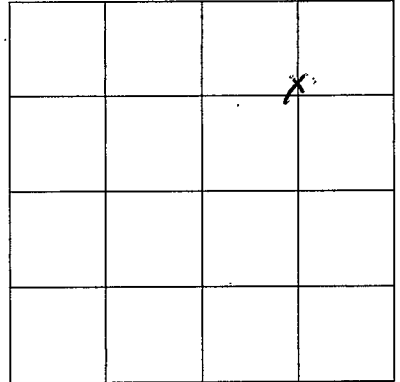

SECTION _____

Please indicate well location X.

ADDITIONAL INFORMATION

If more than one screen,
show location of each on sketch.