

H

10-2-63

WATER WELL DRILLERS LOG

Date: 10-7, 1963, Driller: J B Cain County Panola

(Name)

(1) Owner of Land: Joe King (Name) Sandy Miss (Address)

Description & Color of Materials Sand, Clay, Red Clay, Shell, etc.

Thick-ness Feet


Depth Feet

Brook Sand 0 40 40 105

(2) Location: 1/4, 1/4, Sec. T R, 5 miles E of SARVIS (distance) (direction) (Nearest Town)

(3) Topography: (Hilly) (Flat) (Level)

(4) Purpose of Well: Home (Domestic Irrigation Municipal, Industrial, Other)

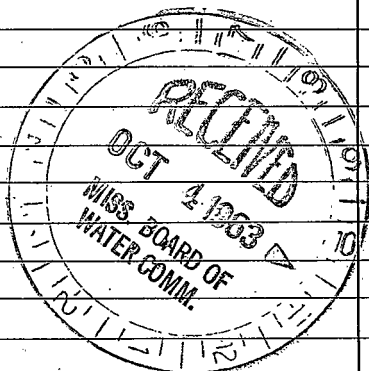

Information upon completion of well:

(1) Diameter 2 inches. (2) Total Depth 105 feet. (3) Water Level 65 feet below top of ground. (4) Cased to 105, Size 2" (5) Screen: Size 1/4, Length 6 FT Plastic well (6) Were any formations sealed against pollution? yes, no.

If YES depth of formation Why Drillers Remarks:

Well No.

(Use Back Side)

