

PANOLA MISSISSIPPI BOARD OF WATER COMMISSIONERS

H

3-20-66

WATER WELL DRILLERS LOG

Date: 3-20, 1966, Driller: J B Cain County: Panola

(Name)

(1) Owner of Land:	Description & Color of Materials Sand, Clay, Red Clay, Shell, etc.	Thick- ness Feet	Depth Feet
<u>H H Sutton</u> (Name) <u>Lambert Miss</u> (Address)	<u>DRY Clay</u> <u>sand</u>	<u>0</u>	<u>65</u> <u>65</u> <u>112</u>
(2) Location: _____ 1/4, _____ 1/4, Sec. _____ T R _____			
<u>10</u> miles <u>E</u> , of <u>Lardin</u> (distance) (direction) (Nearest Town)			
(3) Topography: <input checked="" type="checkbox"/> (Hilly) <input type="checkbox"/> (Flat) <input type="checkbox"/> (Level)			
(4) Purpose of Well: <u>Other</u> (Domestic Irrigation Municipal, Industrial, Other)			


Information upon completion of well:

- (1) Diameter 2 inches.
- (2) Total Depth 112 feet.
- (3) Water Level 80 feet below top of ground.
- (4) Cased to 112, Size 2"
- (5) Screen Size 3", Length 5 FT
Plastic Screen
- (6) Were any formations sealed against pollution?
_____ yes, _____ no.

If YES depth of formation _____

Why _____

Drillers Remarks: _____

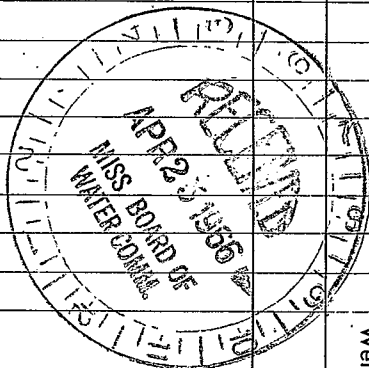

(Use Back Side)

Well No. _____

