

PANOLA  
H

WATER WELL DRILLERS LOG

Date: 3-25-66, 1966, Driller: J B Cain County: Panola  
3-25-66 (Name)

(1) Owner of Land: H C Clayton  
 (Name)  
Lorbin  
 (Address)

Description & Color of Materials Sand, Clay, Red Clay, Shell, etc.	Thick- ness Feet	Depth Feet
<u>brown clay</u>	<u>0</u>	<u>40</u>
<u>gravel</u>	<u>10</u>	<u>80</u>
<u>blue clay</u>	<u>30</u>	<u>120</u>
<u>sand</u>	<u>120</u>	<u>145</u>

(2) Location: 1/4, 1/4, Sec. T, R. R  
6 miles E of Sardis  
 (distance) (direction) (Nearest Town)


(3) Topography: Subsidence  
 (Hilly) (Flat) (Level)

(4) Purpose of Well: Subsidence  
 (Domestic Irrigation  
 Municipal, Industrial, Other)

Information upon completion of well:

- (1) Diameter 4" inches.
- (2) Total Depth 145 feet.
- (3) Water Level 89 feet below top of ground.
- (4) Cased to 145, Size 4"
- (5) Screen: Size 3", length 10 FT  
Plastic Screen
- (6) Were any formations sealed against pollution?  
 yes,  no.

If YES depth of formation \_\_\_\_\_  
 Why \_\_\_\_\_  
 Drillers Remarks: \_\_\_\_\_

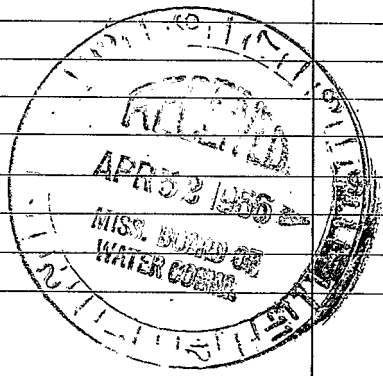

(Use Back Side)

Well No.

