

STATE BOARD OF WATER COMMISSIONERS

PANOLA

WATER WELL DRILLERS LOG

Date: 4-15-66, Driller: J. B. Cain County: Panola
(Name)

(1) Owner of Land: Jay Hilde
(Name)
Sandy Miss
(Address)

(2) Location: 1/4, 1/4, Sec. T R. R,
1/2 miles E, of SARVIS
(distance) (direction) (Nearest Town)

(3) Topography: (Hilly) (Flat) (Level)

(4) Purpose of Well: Home
(Domestic Irrigation, Municipal, Industrial, Other)

| Description & Color of Materials Sand, Clay, Red Clay, Shell, etc. | Thick- ness Feet | Depth Feet |
|---|------------------------|---------------|
| <u>Brd Clay</u> | <u>0</u> | <u>50</u> |
| <u>Sand</u> | <u>50</u> | <u>98</u> |
| <u>Blue Clay</u> | <u>28</u> | <u>170</u> |
| <u>Sand</u> | <u>170</u> | <u>200</u> |

Information upon completion of well:

(1) Diameter 4 inches.

(2) Total Depth 200 feet.

(3) Water Level 108 feet below top of ground.

(4) Cased to 200, Size 4".


(5) Screen: Size 3/4", Length 5 FT
Plastic screen

(6) Were any formations sealed against pollution?
_____ yes, _____ no.

If YES depth of formation _____

Why _____

Drillers Remarks: _____

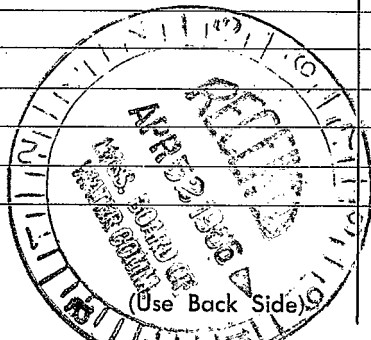

Well No.

