

MISSISSIPPI BOARD OF WATER COMMISSIONERS

WATER WELL DRILLERS LOG

7-12-66

Date: 7-12, 1966, Driller: Jerry Robinson County Panola
 (When well drilled) (Name) (Where well is located)

(1) Owner of Land: Mary Williams
 (Name)
Rt 2, Batesville, Miss
 (Address)

(2) Location: 1/4, 1/4, Sec. T. R.
12 miles NE of B'ville
 (distance) (direction) (Nearest Town)

(3) Topography: ✓
 (Hilly) (Flat) (Level)

(4) Purpose of Well: Home
 (Domestic Irrigation
 Municipal, Industrial, Other)

Description & Color of Materials Sand, Clay, Red Clay, Shell, etc.	Thick- ness Feet	Depth Feet
<u>Red Clay</u>	<u>0</u>	<u>20</u>
<u>Sand + Clay</u>	<u>20</u>	<u>60</u>
<u>Blue Clay</u>	<u>60</u>	<u>100</u>
<u>Sand + Clay</u>	<u>100</u>	<u>140</u>
<u>Sand</u>	<u>140</u>	<u>160</u>

Information upon completion of well:

(1) Diameter 4 inches.

(2) Total Depth 160 feet.

(3) Water Level 80 feet below top of ground.


(4) Cased to 155, Size 4 in.

(5) Screen: Size 6 in, Length 5 ft.

(6) Were any formations sealed against pollution?
 yes, ✓ no.

If YES depth of formation
 Why

Drillers Remarks: Plastic well
 Yield in gpm: 200-18 gal
 Size pump: 1/2 H.P. submersible
 Type power: T.H.A. 220

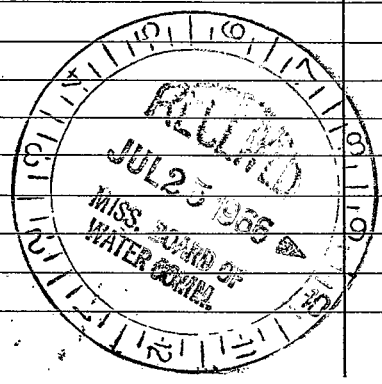

Mail this copy to Board of Water Commissioners 429 Miss. St. Jackson, Miss.

The first part of the document discusses the importance of maintaining accurate records of all transactions. It emphasizes that every entry should be clearly documented and verified. The second section covers the process of reconciling accounts, ensuring that all entries match the actual financial data. This involves comparing the ledger with bank statements and receipts. The third part of the document addresses the need for regular audits to detect any discrepancies or errors. It suggests that audits should be conducted at regular intervals and by an independent party. The final section discusses the importance of transparency and accountability in financial reporting. It states that all financial activities should be open to scrutiny and that any irregularities should be reported immediately.