

CODED

CODED

PANOLA
H 3
10/22/68

MISSISSIPPI
BOARD OF WATER COMMISSIONERS
416 North State Street
Jackson, Mississippi 39201
WATER WELL DRILLERS LOG

10/29/68 19 Morrison Drilling Co. Panola
date well completed firm name county well located
Livingston, La.

LANDOWNER: Shell Oil Co.

description of formations encountered	from	to
---------------------------------------	------	----

Pipe Line Pumping Station

Sardis, Miss.
(mailing address)

WELL LOCATION:

sec. 15 T 7 N R 6 E
S W
5 miles E of Sardis
(distance) (direction) (nearest town)

WELL PURPOSE:
(home, irrigation, municipal, industrial)

WELL COMPLETION DATA:


- (1) diameter (inches) 9
- (2) total depth (feet) 400
- (3) static water level (feet) below top of ground.
- (4) casing none (material) (depth),
(size) If telescope see back.
- (5) screen none (length) (depth to top),
(size) (material)
- (6) pump (HP) (yield gpm),
(type power)
- (7) electric log (yes or no)
(organization running log)
- (8) how well bottom plugged

DRILLERS REMARKS:

This is an anode hole,
not a water well.
Encountered good sands.

clay	0	44
sand	45	110
clay and sand	111	132
clay	133	154
clay then sand	155	176
clay	177	198
hard sand	199	220
sand then clay	221	242
sandy clay	243	286
sand	287	308
hard sand	309	352
sand	353	400

CODED

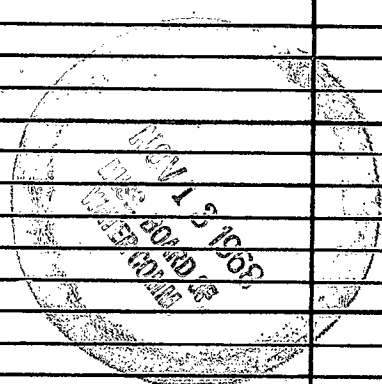

If well telescopes please
sketch and show depths.

GROUND LEVEL

SECTION _____

Please indicate well location X.

ADDITIONAL INFORMATION

If more than one screen,
show locations of each on sketch.