

MISSISSIPPI BOARD OF WATER COMMISSIONERS
416 North State Street
Jackson, Mississippi 39201

CODED

WATER WELL DRILLERS LOG

Big stream well Dry 6'

Parola
H 4
9-1-69

9-1-69
date well completed

J. By
driller name

Parola
county well located

LANDOWNER *Wm H. Clay*

Description of formations encountered

from to

Sands
Miss
(mailing address)

<i>Bro cl</i>	<i>0</i>	<i>5</i>
<i>sand</i>	<i>5</i>	<i>138</i>
<i>Rock</i>	<i>130</i>	<i>131</i>
<i>sand</i>	<i>131</i>	<i>137</i>
<i>Blue cl</i>	<i>147</i>	<i>190</i>
<i>sand</i>	<i>190</i>	<i>225</i>
<i>Blue cl</i>	<i>225</i>	<i>230</i>
<i>sand</i>	<i>230</i>	<i>240</i>
<i>Blue cl</i>	<i>240</i>	<i>255</i>
<i>sand cl sh</i>	<i>235</i>	<i>330</i>
<i>Rock</i>	<i>330</i>	<i>380</i>
<i>clay</i>	<i>385</i>	<i>386</i>
<i>sand</i>	<i>386</i>	<i>395</i>
<i>Blue cl</i>	<i>395</i>	<i>487</i>
<i>sand</i>	<i>487</i>	<i>500</i>
<i>Blue cl</i>	<i>500</i>	<i>510</i>
<i>sand + cl. sh</i>	<i>510</i>	<i>620</i>
<i>Blue cl</i>	<i>620</i>	<i>790</i>
<i>sand</i>	<i>790</i>	<i>840</i>
<i>Blue cl</i>	<i>840</i>	<i>868</i>
<i>sand</i>	<i>868</i>	<i>885</i>
<i>sand</i>	<i>885</i>	<i>931</i>

WELL LOCATION:
sec. *33* T. *7* N. R. *6* E. S. *1* W.
0.5 miles *E* of *Sanders*
(distance) (direction) (nearest town)

WELL PURPOSE:
(home, irrigation, municipal, industrial)

WELL COMPLETION DATA:

- (1) diameter (inches) *4 X 3*
- (2) total depth (feet) *931*
- (3) static water level (feet) *120* below top of ground.
- (4) casing *Steel*, *9 1/2* (material), *9 1/2* (depth)
- 4 X 3* If telescope see back. (size)
- (5) screen *20*, *9 1/2* (length), (depth to top)
- 3"*, *Stainless S* (size), (material)
- (6) pump *3/4*, *10* (HP), (yield gpm)
- Electric* (type power)
- (7) electric log *?* (yes or no)

CODED

(organization running log)

(8) how well bottom plugged. *Wash Bottom*



DRILLERS REMARKS:

OCT 13 1969

MISS. BD. OF WATER COMM.

If well telescopes please sketch and show depths.

GROUND LEVEL

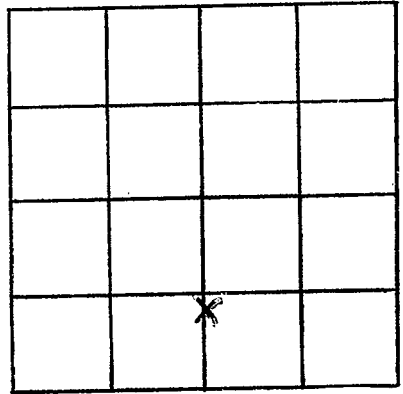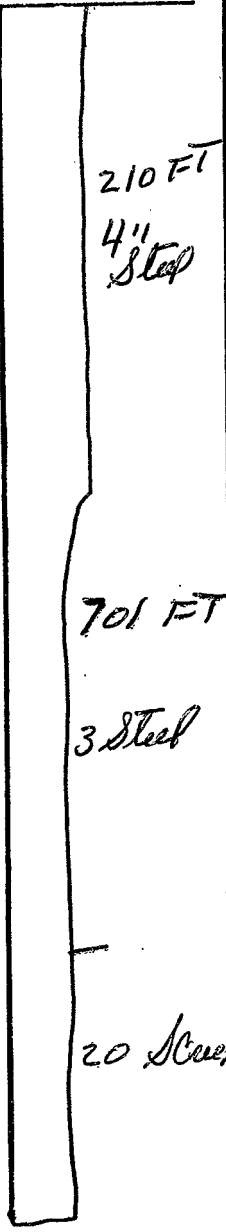

SECTION 33

Please indicate well location X.

ADDITIONAL INFORMATION

Lined area for additional information.

If more than one screen, show locations of each on sketch.