

MISSISSIPPI BOARD OF WATER COMMISSIONERS

PANOLA

H5
12-27-60

WATER WELL DRILLERS LOG

CODED

CODED

Date: 12, 27, 1960, Driller: James R. Viper, County: Panola
(Name)

(1) Owner of Land: Wesley Adams
(Name)
Sardis, Miss
(Address)

(2) Location: $\frac{1}{4}$, $\frac{1}{4}$, Sec. 16 T 7 R 6
S W
5 miles N. east, of Sardis
(distance) (direction) (Nearest Town)

(3) Topography: (Hilly) (Flat) (Level)

(4) Purpose of Well: Domestic
(Domestic Irrigation
Municipal, Industrial, Other)

| Description & Color of Materials Sand, Clay, Red Clay, Shell, etc. | Thick- ness Feet | Depth Feet |
|---|------------------------|---------------|
| <u>Red clay</u> | <u>2</u> | <u>20</u> |
| <u>gravel</u> | <u>2</u> | <u>60</u> |
| <u>White sand</u> | <u>50</u> | <u>100</u> |
| <u>Black clay</u> | <u>100</u> | <u>160</u> |
| <u>sand</u> | <u>160</u> | <u>181</u> |

Information upon completion of well:

(1) Diameter 2 inches.

(2) Total Depth 181 feet.

(3) Water Level 60 feet below top of ground.

(4) Cased to 107, Size 2"

(5) Screen: Size 1/4", Length 6'


(6) Were any formations sealed against pollution?
_____ yes, _____ no.

If YES depth of formation _____

Why _____

Drillers Remarks: _____

CODED

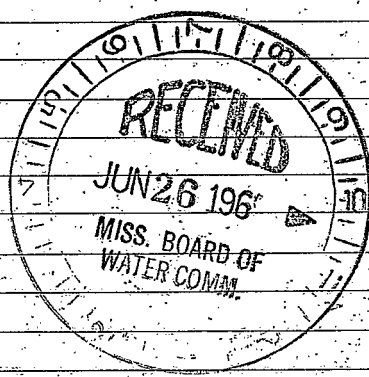

(Use Back Side)

Well No.

