

PANOLA
E H 6

WATER WELL DRILLERS LOG

CODED

CODED

Date: 11/29, 1960, Driller: Jas. R. Lipe County: Panola

11-29-60

- (1) Owner of Land: A. D. Jackson
(Name)
Audis, Miss
(Address)
- (2) Location: 1/4, 1/4, Sec. 32 T. 7 R. 6
S W
_____ miles _____ of _____
(distance) (direction) (Nearest Town)
- (3) Topography: Hilly
(Hilly) (Flat) (Level)
- (4) Purpose of Well: Domestic
(Domestic Irrigation
Municipal, Industrial, Other)

Description & Color of Materials Sand, Clay, Red Clay, Shell, etc.	Thick- ness Feet	Depth Feet
<u>Clay & top soil</u>	<u>0</u>	<u>20</u>
<u>Red Shaly clay</u>	<u>20</u>	<u>40</u>
<u>red sand</u>	<u>30</u>	<u>70</u>
<u>Sand & gravel</u>	<u>65</u>	<u>75</u>
<u>uplying sand</u>	<u>75</u>	<u>118</u>

Information upon completion of well:


CODED

- (1) Diameter: 2 inches.
- (2) Total Depth: 118' feet.
- (3) Water Level: 90 feet below top of ground.
- (4) Cased to: 110, Size: 2
- (5) Screen: Size: 1/4, Length: 6'
- (6) Were any formations sealed against pollution?
_____ yes, no.

If YES depth of formation _____

Why _____

Drillers Remarks: _____

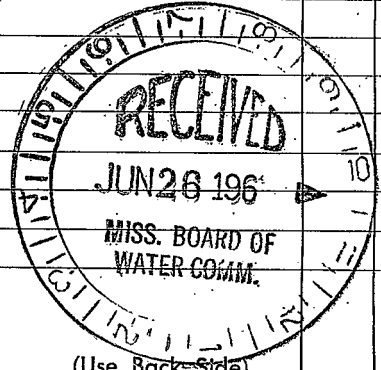

(Use Back Side)

Retain this copy for your office files.

Well No.

