

PANOLA MISSISSIPPI BOARD OF WATER COMMISSIONERS

~~H9~~ James Ray Lipe
6-9-66 WATER WELL DRILLERS LOG

CODED

Date: 6.9, 1966, Driller: Frank Taylor County Panola
(Name)

(1) Owner of Land: Claud Beeler
(Name)
Sardis Miss.
(Address)

(2) Location: 1/4, 1/4, Sec. 32 7 6
5 R W
6 miles east of Sardis
(distance) (direction) (Nearest Town)

(3) Topography: Hilly
(Hilly) (Flat) (Level)

(4) Purpose of Well: Domestic
(Domestic Irrigation
Municipal, Industrial, Other)

Description & Color of Materials Sand, Clay, Red Clay, Shell, etc.	Thick- ness Feet	Depth Feet
<u>red clay</u>	<u>0</u>	<u>20</u>
<u>red sand</u>	<u>20</u>	<u>40</u>
<u>white sand</u>	<u>40</u>	<u>60</u>
<u>'' ''</u>	<u>60</u>	<u>80</u>
<u>gravel</u>	<u>80</u>	<u>100</u>
<u>''</u>	<u>100</u>	<u>120</u>
<u>watersand</u>	<u>120</u>	<u>150</u>

Information upon completion of well:

(1) Diameter 4 inches.

(2) Total Depth 150 feet.

(3) Water Level 100 feet below top of ground.

(4) Cased to 144, Size 4"

(5) Screen: Size 4", Length 6'


(6) Were any formations sealed against pollution?
_____ yes, _____ no.

CODED

If YES depth of formation _____

Why _____

Drillers Remarks: _____

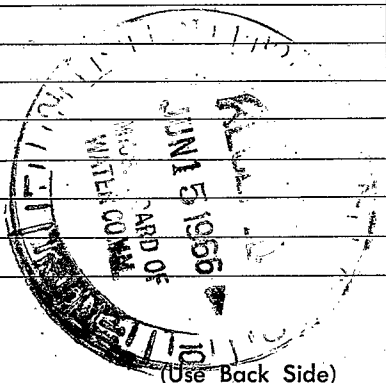

Well No.

