

Panola
H 14
5-70

MISSISSIPPI
BOARD OF WATER COMMISSIONERS
416 North State Street
Jackson, Mississippi 39201

CODED

WATER WELL DRILLERS LOG

May 20 1970 J. LEON WHITE Panola
date well completed firm name county well located

LANDOWNER:
J.W. WEAVER
SARDIS, Miss. 38581
(mailing address) 005
WELL LOCATION:
sec. 25 T 7 N R 6 W
8 miles EAST of SARDIS
(distance) (direction) (nearest town)

description of formations encountered	from	to
TOP SOIL	0	28
SAND ROCK	28	34
MIXED SAND	34	76
BLUE CLAY	76	120
MIXED SAND & CLAY	120	130
DEP. COARSE WHITE SAND	130	140

WELL PURPOSE: HOME
(home, irrigation, municipal, industrial)

WELL COMPLETION DATA:
(1) diameter (inches) 2"
(2) total depth (feet) 140'
(3) static water level (feet) 82 (below top of ground)
(4) casing STEEL 132' (material) (depth)
2" (size) If telescope see back.
(5) screen 4' 140' (length) (depth to top)
1 1/4" STAINLESS STEEL (size) (material)
(6) pump 3/4 HP 3 (yield gpm)
ELE. (type power)
(7) electric log No (yes or no)
(organization running log)
(8) how well bottom plugged STRAINER

CODED


JUN 4 1970

MISS. BD. OF
WATER COMMISSIONERS

DRILLERS REMARKS:

If well telescopes please sketch and show depths.

GROUND LEVEL

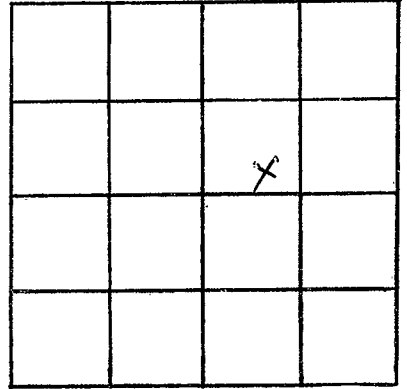

SECTION 25

Please indicate well location X.

ADDITIONAL INFORMATION

If more than one screen, show locations of each on sketch.