

PANDOLA

Date: 5-7, 1963, Driller: Adams Bros. Co. Inc. County: Pandola

15

(Name)

CODED

(1) Owner of Land: James Bennie (Name)

Sardin (Address) 2576

(2) Location: 1/4, 1/4, Sec. T R, miles, of (distance) (direction) (Nearest Town)

(3) Topography: (Hilly) (Flat) (Level)

(4) Purpose of Well: (Domestic Irrigation Municipal, Industrial, Other)

Description & Color of Materials Sand, Clay, Red Clay, Shell, etc.	Thickness Feet	Depth Feet
top soil	0	15
sand	15	35
black clay	35	105
fine sand + black clay	105	130
medium coarse sand	130	150

Information upon completion of well:

(1) Diameter 4 inches.

(2) Total Depth 150 feet.

(3) Water Level 60 feet below top of ground.

(4) Cased to 136, Size

(5) Screen: Size 4", Length 14'


(6) Were any formations sealed against pollution? yes, no.

If YES depth of formation

Why

Drillers Remarks:

CODED

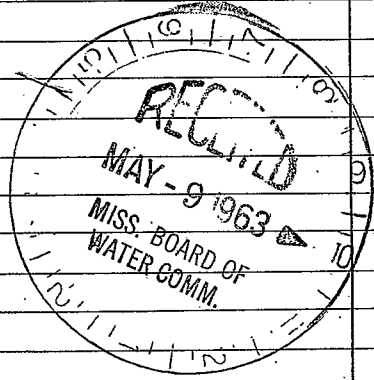

(Use Back Side)

Well No.

