

PANOLA

WATER WELL DRILLERS LOG

H 20

Date: 2-23, 1962, Driller: J B CAIN, County PANOLA

(Name)

CODED

(1) Owner of Land: Georg Scallon
(Name)
Route 4 SARVIS MISS
(Address)

Description & Color of Materials
Sand, Clay, Red Clay, Shell, etc.

Thick-
ness
Feet

Depth
Feet

Bro of
Red sand
white sand
0 30
30 130
130 153

(2) Location: SW 1/4, 15 T 756 W

6 miles N-E of SARVIS
(distance) (direction) (Nearest Town)

(3) Topography: (Hilly) (Flat) (Level)

(4) Purpose of Well: Home
(Domestic Irrigation
Municipal, Industrial, Other)

Information upon completion of well:



- (1) Diameter 2 inches.
- (2) Total Depth 153 feet.
- (3) Water Level 86 feet below top of ground.
- (4) Cased to 153, Size 2"
- (5) Screen: Size 2", Length 5 FT
- (6) Were any formations sealed against pollution?
_____ yes, no.

CODED

If YES depth of formation _____

Why _____

Drillers Remarks: _____

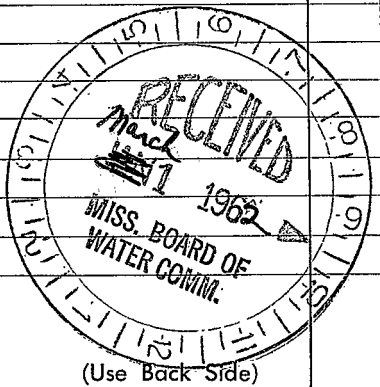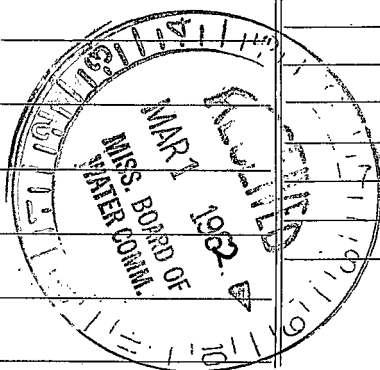

Well No. _____

Retain this copy for your office files.

