

PANOLA

H 23

WATER WELL DRILLERS LOG

10-3-62

Date: 10-3, 1962, Driller: J B C **CODED** County Panola

(Name)

(1) Owner of Land:	Description & Color of Materials Sand, Clay, Red Clay, Shell, etc.	Thick- ness Feet	Depth Feet
Walter C. Stearns (Name)	Clay Grey	0	20
Rout 1 Lardis Miss (Address)	Sand Red	20	110
	Sand white	110	130
(2) Location: 1/4, 1/4, Sec. 14 T 7 R 1 W			
West 2 miles EAST (distance) (direction) of Lardis Miss (Nearest Town)			
(3) Topography: <input checked="" type="checkbox"/> (Hilly) <input type="checkbox"/> (Flat) <input type="checkbox"/> (Level)			
(4) Purpose of Well: Home (Domestic Irrigation, Municipal, Industrial, Other)			

Information upon completion of well:


- (1) Diameter 2 inches.
- (2) Total Depth 130 feet.
- (3) Water Level 90 feet below top of ground.
- (4) Cased to 130, Size 2"
- (5) Screen: Size 2", Length 80 FT
- (6) Were any formations sealed against pollution?  
 yes,  no.

If YES depth of formation \_\_\_\_\_

Why \_\_\_\_\_

Drillers Remarks: \_\_\_\_\_

**CODED**

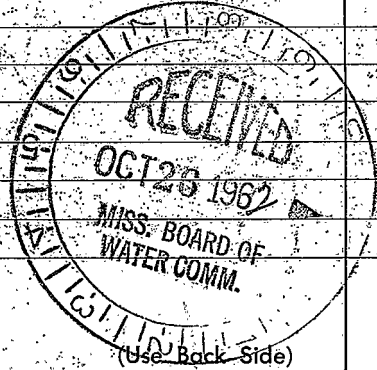

Well No

