

Panola
H 27
4-30-74

MISSISSIPPI
 BOARD OF WATER COMMISSIONERS
 416 North State Street
 Jackson, Mississippi 39201

WATER WELL DRILLERS LOG

APRIL 30 1974 J. LEON WHITE PANOLA
 date well completed firm name county well located

LANDOWNER:

C. L. Chambers

Como, Miss.
 (mailing address)

WELL LOCATION:

sec. 3 T. 7 N. R. 6 E.
6 miles E. of Como
 (distance) (direction) (nearest town)

WELL PURPOSE: FARM
 (home, irrigation, municipal, industrial)

WELL COMPLETION DATA:

- (1) diameter (inches) 4"
- (2) total depth (feet) 155'
- (3) static water level (feet) 82 ^{below} above top of ground.
- (4) casing PLASTIC, 155',
 (material) (depth)
4" if telescope see back.
 (size)
- (5) screen 6 1/2, 155'
 (length) (depth to top)
4, PLASTIC CR. PACK
 (size) (material)
- (6) pump 3/4 10
 (HP) (yield gpm)
ELE.
 (type power)
- (7) electric log NO
 (yes or no)
- (organization running log)
- (8) how well bottom plugged STRAINER

description of formations encountered

| | from | to |
|------------------------------|------------|------------|
| <u>TOP SOIL</u> | <u>0</u> | <u>40</u> |
| <u>SAND CLAY</u> | <u>40</u> | <u>55</u> |
| <u>YELLOW CLAY</u> | <u>55</u> | <u>70</u> |
| <u>FINE SAND</u> | <u>70</u> | <u>90</u> |
| <u>SAND ROCK</u> | <u>90</u> | <u>120</u> |
| <u>MED COARSE WHITE SAND</u> | <u>120</u> | <u>155</u> |


CODED

DRILLERS REMARKS:

MAY - 6 1974

If well telescopes please sketch and show depths.

GROUND LEVEL

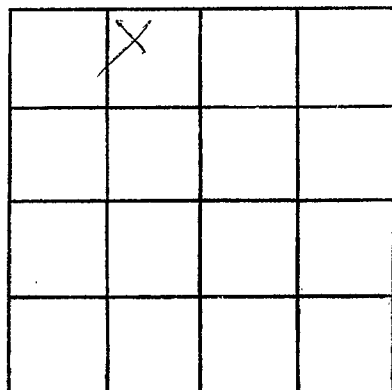

SECTION _____

Please indicate well location X.

ADDITIONAL INFORMATION

If more than one screen, show locations of each on sketch.