

PANOLA
H 28
4-6-74

MISSISSIPPI
BOARD OF WATER COMMISSIONERS
416 North State Street
Jackson, Mississippi 39201

WATER WELL DRILLERS LOG

CODED

4-6
date well completed

1974 Life Well Co.
firm name

Panola
county well located

LANDOWNER:	description of formations encountered	from	to
Ray Conrad	TOP Soil	0	20
SARDIS MISS.	red sand	20	40
(mailing address)	red gravel	40	60
	sand	60	80

WELL LOCATION:
sec 31 T 07 N R 6 E
2 miles S. E. of SARDIS
(distance) (direction) (nearest town)

WELL PURPOSE:
(home) irrigation, municipal, industrial

- WELL COMPLETION DATA:
- (1) diameter (inches) 4
 - (2) total depth (feet) 80
 - (3) static water level (feet) 60 below top of ground.
 - (4) casing PVC 70 (material) (depth)
4 (size) If telescope see back.
 - (5) screen 10 70 (length) (depth to-top)
4 PVC (size) (material)
 - (6) pump 3/4 10 (HP) (yield gpm)
elec (type power)
 - (7) electric log no (yes or no)
no (organization running log)
 - (8) how well bottom plugged PVC plug


CODED

DISC
WAY 1

DRILLERS REMARKS:

If well telescopes please sketch and show depths.

GROUND LEVEL

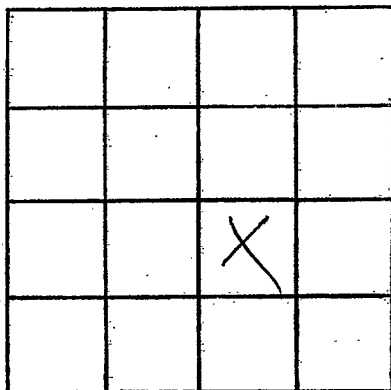

SECTION 31

Please indicate well location X.

ADDITIONAL INFORMATION

If more than one screen, show locations of each on sketch.