

PANOLA  
H 29  
4-11-74

MISSISSIPPI  
BOARD OF WATER COMMISSIONERS  
416 North State Street  
Jackson, Mississippi 39201

CODED

WATER WELL DRILLERS LOG

4-11 1974 LiPe well Co Panola  
date well completed firm name county well located

LANDOWNER:  
William Davis  
Como Miss.  
(mailing address)

description of formations encountered	from	to
Top soil	0	20
red sand	20	40
sand and clay	40	60
cc cc cc	60	80
cc cc cc	80	100
White Sand	100	160

WELL LOCATION:  
sec 35 T 9 N R 6 E  
8 miles East of Como  
(distance) (direction) (nearest town)

WELL PURPOSE:  
(home, irrigation, municipal, industrial)

- WELL COMPLETION DATA:
- (1) diameter (inches) 4
  - (2) total depth (feet) 160
  - (3) static water level (feet) 90 below above top of ground.
  - (4) casing PVC 150 (material) (depth)
  - 4 (size) if telescope see back.
  - (5) screen 10 150 (length) (depth to top)
  - 4 PVC (size) (material)
  - (6) pump 3/4 10 (HP) (yield gpm)
  - elec. (type power)
  - (7) electric log no (yes or no)
  - no (organization running log)
  - (8) how well bottom plugged PVC plug


CODED

DRILLERS REMARKS:

APR 16 1974

If well telescopes please sketch and show depths.

GROUND LEVEL

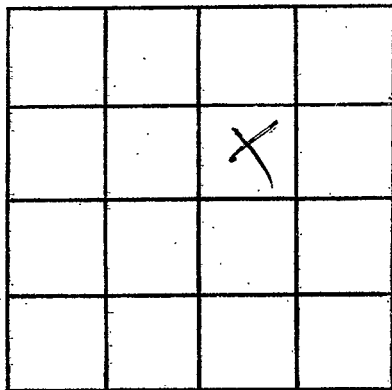

SECTION 35

Please indicate well location X.

ADDITIONAL INFORMATION

If more than one screen, show locations of each on sketch.