

PANOLA
~~H-2-17-30~~
 5-25-73

MISSISSIPPI
 BOARD OF WATER COMMISSIONERS
 416 North State Street
 Jackson, Mississippi 39201

WATER WELL DRILLERS LOG

5-25-1973 date well completed
 Bob Hill firm name
 Panola county well located

LANDOWNER:
 O. D. Flynn
 Commo - miss.
 (mailing address)

description of formations encountered	from	to
Clay dirt	70	16
Red sand	18	43
white sand	145	145

WELL LOCATION:
 sec. 2 T 47 N R 76 E
 8 miles East of Commo
 (distance) (direction) (nearest town)

WELL PURPOSE: Home
 (home, irrigation, municipal, industrial)

- WELL COMPLETION DATA:
- (1) diameter (inches) 4
 - (2) total depth (feet) 145
 - (3) static water level (feet) 60 below top of ground.
 - (4) casing Plastic 145
 (material) (depth)
 _____ if telescope see back.
 (size)
 - (5) screen 20 135
 (length) (depth to top)
 4 Plastic
 (size) (material)
 - (6) pump 1/2 10
 (HP) (yield gpm)
 Elee
 (type power)
 - (7) electric log 70
 (yes or no)
 - _____ (organization running log)
 - (8) how well bottom plugged plugged


CODED

MISS. 20 DE WATER BOARD
 JUNE 24 1974

DRILLERS REMARKS:

If well telescopes please sketch and show depths.

GROUND LEVEL

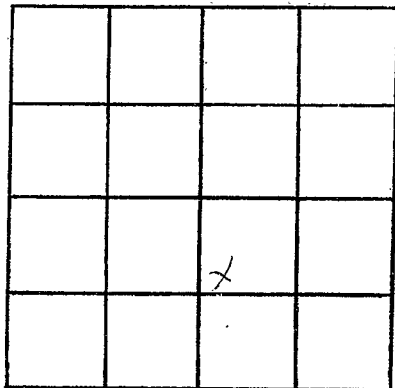

SECTION 2

Please indicate well location X.

ADDITIONAL INFORMATION

If more than one screen, show locations of each on sketch.