

PANOLA
H 32
3-1-75

MISSISSIPPI
BOARD OF WATER COMMISSIONERS
416 North State Street
Jackson, Mississippi 39201

WATER WELL DRILLERS LOG


March 1 1975 Nelson Cain Panola
date well completed firm name county well located

LANDOWNER: <u>Louis G. Clay Jr.</u>	description of formations encountered	from	to
(mailing address)	Clay & sand streak	0	80
	Sand	80	120
WELL LOCATION:			
sec <u>27</u> T <u>7</u> N R <u>6</u> E <u>6</u> miles <u>S</u> of <u>SARDIS</u> (distance) (direction) (nearest town)			
WELL PURPOSE: <u>HOME</u> (home, irrigation, municipal, industrial)			
WELL COMPLETION DATA:			
(1) diameter (inches) <u>4"</u>			
(2) total depth (feet) <u>120</u>			
(3) static water level (feet) <u>90</u> below top of ground.			
(4) casing <u>PLASTIC</u> , <u>120</u> , (material) (depth)			
(size) If telescope see back.			
(5) screen <u>10'</u> , <u>110'</u> (length) (depth to top)			
<u>4"</u> , <u>PLASTIC</u> (size) (material)			
(6) pump <u>3/4</u> <u>10</u> (HP) (yield gpm)			
<u>Elec-</u> (type power)			
(7) electric log <u>No</u> (yes or no)			
(organization running log)			
(8) how well bottom plugged <u>Wash Bot</u>			
DRILLERS REMARKS:			

MAR 31 1975
MISS. BD. OF WATER COMMISSIONERS

If well telescopes please sketch and show depths.

GROUND LEVEL

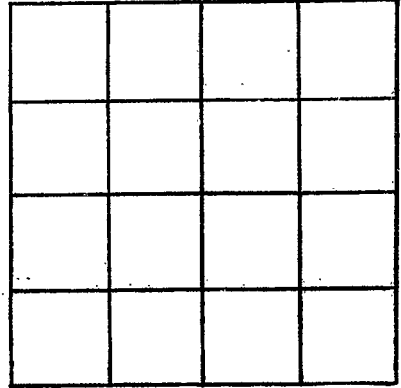

SECTION _____

Please indicate well location X.

ADDITIONAL INFORMATION

If more than one screen, show locations of each on sketch.