

MISSISSIPPI DEPARTMENT OF NATURAL RESOURCES

Bureau of Land and Water Resources

Southport Mall

P.O. Box 10631

Jackson, Mississippi 39209

WATER WELL DRILLERS LOG

CODED

LANOLA  
H 35

6-28-1988  
date well completed

19 LIPE WELL & SUPPLY CO.  
firm name

LANOLA  
county well located

LANDOWNER: YARBROUGH FARMS

P.O. Box 278

COMO, MS 38619  
(mailing address)

WELL LOCATION:

sec. 6 T. 7 N. R. 6 E.  
S. W.  
5 miles SE of COMO  
(distance) (direction) (nearest town)

WELL PURPOSE: IRRIGATION  
(home, irrigation, municipal, industrial)

WELL COMPLETION DATA:

- (1) diameter (inches) 8"
- (2) total depth (feet) 198'
- (3) static water level (feet) 53 below above top of ground.
- (4) casing PVC, 158'  
(material) (depth)  
8" if telescope see back.  
(size)
- (5) screen 40', 158'  
(length) (depth to top)  
8", PVC 1020"  
(size) (material)
- (6) pump 20, 500  
(HP) (yield gpm)  
230 3/4  
(type power)
- (7) electric log NO  
(yes or no)

(organization running log)

(8) how well bottom plugged CAP

description of formations encountered	from	to
TOP SOIL & CLAY	0	15
SAND	15	40
SAND & GRAVEL	40	60
COARSE SAND	60	80
COARSE SAND	80	100
COARSE SAND W/ GRAVEL	100	140
GRAVEL	140	160
SAND & GRAVEL	160	180
SAND & GRAVEL W/ CLAY	180	200


RECEIVED  
DEC 21 1988

Department of Natural Resources  
Bureau of Land & Water Resources

DRILLERS REMARKS:

If well telescopes please sketch and show depths.

GROUND LEVEL

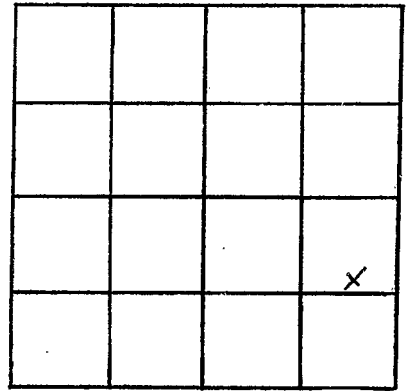

SECTION 6

Please indicate well location X.

ADDITIONAL INFORMATION

If more than one screen, show locations of each on sketch.