

MISSISSIPPI DEPARTMENT OF NATURAL RESOURCES

Bureau of Land and Water Resources

Southport Mall

P.O. Box 10631

Jackson, Mississippi 39209

WATER WELL DRILLERS LOG

CODED

PANOLA
H 36

6-25-1988
date well completed

LIFE WELL AND SUPPLY
firm name

PANOLA
county well located

LANDOWNER: YARBROUGH FARMS

description of formations encountered

from

to

P.O. Box 278
COMO, MS 38619
(mailing address)

TOP SOIL & CLAY	0	15
SAND	15	40
SAND & GRAVEL	40	60
COARSE SAND	60	80
COARSE SAND	80	100
COARSE SAND W/GRAVEL	100	140
GRAVEL	140	160
SAND & GRAVEL	160	180
SAND & GRAVEL W/CLAY	180	200

WELL LOCATION:

sec. 6 T 7 N R 6 E
S W
5 miles SE of COMO
(distance) (direction) (nearest town)

WELL PURPOSE: IRRIGATION
(home, irrigation, municipal, industrial)

WELL COMPLETION DATA:

- (1) diameter (inches) 8"
- (2) total depth (feet) 192'
- (3) static water level (feet) 47' below top of ground.
- (4) casing PVC, 152' (depth)
8" (size) if telescope see back.
- (5) screen 40' (length), 152' (depth to top)
8" (size), PVC .020" (material)
- (6) pump 20 (HP), 300 (yield gpm)
230 3d (type power)
- (7) electric log NO (yes or no)
(organization running log)
- (8) how well bottom plugged CAP

RECEIVED


DEC 21 1988

Department of Natural Resources
Bureau of Land & Water Resources

DRILLERS REMARKS:

If well telescopes please sketch and show depths.

GROUND LEVEL

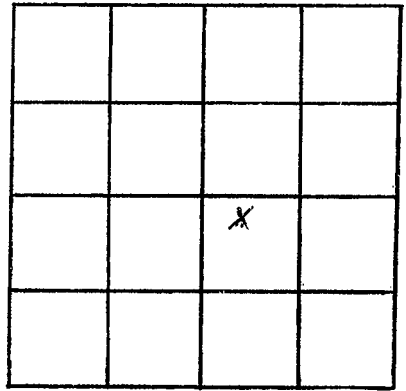

SECTION 6

Please indicate well location X.

ADDITIONAL INFORMATION

If more than one screen,
show locations of each on sketch.