

MISSISSIPPI DEPARTMENT OF ENVIRONMENTAL QUALITY
Office of Land and Water Resources

P. O. Box 10631
Jackson, MS 39289-0631
WATER WELL DRILLERS LOG

COUNTY WELL LOCATED LANOCHA	
WELL NUMBER 230	CODED
H39	
DATE WELL COMPLETED 4-7-01	

PERMIT NUMBER
NAME OF DRILLING FIRM SMITH WELLS DRILLING & S.W.

NAME & MAILING ADDRESS OF LANDOWNER JERRY PRICE			
LIBERTY HILL RD.			
COMO, MS.			
WELL LOCATION: SEC	TOWNSHIP	RANGE	
D-4	T70	R6	
DISTANCE 5 Miles	DIRECTION S/E of	NEAREST TOWN COMO	
OTHER LANDMARK			
WELL PURPOSE: Home, Irrigation, Municipal, Industrial, Fish Pond, etc. HOME			

PUMP DATA		
PUMP TYPE (Circle One): <input checked="" type="radio"/> Submersible Turbine, Jet Flowing Well, Other (Describe) _____		
POWER TYPE (Circle One): <input checked="" type="radio"/> Electric Tractor, Diesel, Gasoline, Butane, Other (Describe) _____ H/P 3/4		
Pump Capacity (GPM) 12	No. of Stages 10	Setting Depth 120 FT.
PUMP TEST		
Well yielded 15 GPM with a drawdown of 4 ft. after 1 hours of pumping		

WELL DATA		
Well Depth 154	Casing Diameter (In.) 4"	Casing Length (Ft.) 134
Type of Casing PVC	Hole Depth 154	Depth to Static Water Level 86

LOG DATA	
TYPE OF LOG RUN (Circle One): <input type="radio"/> No Log Run, <input type="radio"/> Electric, Gamma Ray, Density, Sonic, Neutron, Other (Describe) _____	
Name of Organization Running Log	

TYPE OF COMPLETION: (Circle One or More): <input type="radio"/> Gravel Packed, <input type="radio"/> Underreamed, <input type="radio"/> Telescoped, <input type="radio"/> Natural Development, <input type="radio"/> Open Hole, <input type="radio"/> Other (Describe) WASHED SAND			
--	--	--	--

GEOLOGIC DATA (Office Use Only)			
Surface Elev.	Geologic Unit	Unit Thickness	Depth to Top
Subs. SWL	Date	Analysis	Aquifer Test

WELL GROUTED TO A DEPTH OF 10 FEET Type Grout (circle one): <input checked="" type="radio"/> Cement, Bentonite, or Mix
--

SCREEN DATA		
Diameter - Inches 4"	Length - Feet 20	Slot Size - Inches 14/100
Screen Type PVC	Depth to Bottom - Feet 154	

Driller's Remarks
Top of Lap Pipe or Reduction in Casing FEET IF TELESCOPED OR MORE THAN ONE SCREEN: USE BACK PAGE

DESCRIPTION OF FORMATIONS ENCOUNTERED	FROM	TO
TOP SOIL	0	20
RED SAND + GRAVEL	20	40
WHITE + RED CLAY	40	70
WHITE CLAY	70	100
WHITE SAND + CLAY	100	120
WHITE SAND	120	154

FORMATIONS ENCOUNTERED FROM TO


JUN 05 2001

**Dept. of Environmental Quality
Office of Land & Water Resources**

IF MORE SPACE IS NEEDED, USE BACK

If well telescopes please sketch and show depths.

GROUND LEVEL

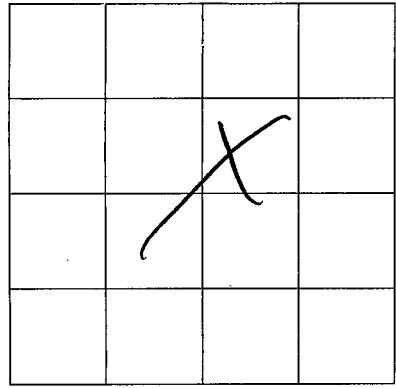

SECTION

D-4

Please indicate well location X.

ADDITIONAL INFORMATION

If more than one screen,
show location of each on sketch.