| County: PANO/A                      |    |
|-------------------------------------|----|
| Permit #:                           | ١, |
| Driller: Ratliff Water Well Service |    |
| Date drilling completed: 11-11-15   |    |

Well Owner Information

(Landowner if borehole is not for a water well)

## STATE WELL REPORT

## Part 1

### Driller's Log

Mississippi Department of Environmental Quality Office of Land and Water Resources P.O. Box 2309 Jackson, MS 39225-2309

(601)961-5210 (601)360-0535 (fax)

| For Office Use Only: Well #: 454 |
|----------------------------------|
| Aquifer:                         |
| E-Log #:                         |

Well or Borehole Location

Latitude: N34030 21.3 Longitude: W89051 49.7"

State Law requires that this report be prepared by the license holder responsible for the work and filed with the Department at the above address within 30 days of completion of drilling of the well or borehole.

| Owner Name: Mike BARtlett  | Latitude: N3403021.3 Longitude: N89057 49.7          |  |  |  |  |
|--|--|--|--|--|--|
| Mailing Address: 1513 Hous Plate Rd.   | Method of Lat/Long (check one): Conventional Survey, |  |  |  |  |
|  | USGS quad, Hand-held GPS_X, Survey-grade GPS         |  |  |  |  |
| Cono Ms. 38619   | NE 4 NE 4, Sec 6 T 75 R6ω                            |  |  |  |  |
| City State Zip Code  | 4 Miles EAST of COUD, US, (Direction) (Nearest Town) |  |  |  |  |
| Telephone No. (662) 292 - 5808   | (Distance) (Direction) (Nearest Town)                |  |  |  |  |
| Well / B   | orehole Data   |  |  |  |  |
| Date drilling started: 1/-10-15 Date drilling completed: 1/-1/-15 Hole depth: 180 Hole diameter: 2.5   |  |  |  |  |  |
| Location of the source of any surface water used for drillir   | ng: Community  |  |  |  |  |
| Method of dosing and volume of Chlorine used in drilling a   | nd development: 50 ppm HTH                           |  |  |  |  |
| Logs run (circle all applicable) No log run Electric Gamn  | na Ray Density Sonic Neutron Other:                  |  |  |  |  |
| Name of organization running log(s):   |  |  |  |  |  |
| Purpose of borehole (circle one) Water Well Geotechnical/Geological Investigation Ground Source Heat Pump  |  |  |  |  |  |
| Seismic Survey Other ( <i>describe</i> )   |  |  |  |  |  |
| If drilling is not related to water well construction, skip the remainder of this block  |  |  |  |  |  |
| Purpose of Well (circle all applicable) Home Industrial Public Supply Irrigation Fish Culture  |  |  |  |  |  |
| Other (describe):  |  |  |  |  |  |
| If a flowing well, method of flow regulation: Valve Other (describe)   |  |  |  |  |  |
| Static Water Level: 74feet [above or below pland surface Date measured:  |  |  |  |  |  |
| Method of measurement (circle one): Steel tape <u>Electric tape</u> Air line Other (describe):   |  |  |  |  |  |
| Well depth: 180 Well grouted to a depth of: 10 feet Type of grout (circle one): Neat Cement Bentonite Mix  |  |  |  |  |  |
|  |  |  |  |  |  |
| Casing length: 160 feet Casing diameter: 4 inches Type of casing: 100 feet Screen diameter: 4 inches Type of screen: 100 feet Screen diameter: 4 inches Type of screen: 100 feet Screen diameter: 100 fe |  |  |  |  |  |
| Screen slot size:013inches Setting depth: Fromfeet_ tofeet_  |  |  |  |  |  |
| Type of completion (circle all applicable): Gravel packed Underreamed Open hole Natural Development  |  |  |  |  |  |
| Other (describe):  |  |  |  |  |  |
| Top of lap pipe or reduction in casing:feet  |  |  |  |  |  |
| If telescoped or more than one screen, describe on next page   |  |  |  |  |  |

| 1  | Fo  | or Office Use  | Only:                  |
|--|---|--|------------------------|
| Permit #:  | Well #:   |  |                        |
| The sketch below only required for water wells   | Description of formations encountered and boreholes, unless specifically exer |  |                        |
| If well telescopes, show depths on sketch.   | Description of Formations Encountered   | From (depth)   | To (depth)             |
| Ground Level   | PEA GRAVE!  | Ground level   | 40                     |
|  | PEA GRAVEI  | 40   | 100                    |
|  | CIAY  | 100  | 130                    |
|  | CIAY  | /30  | 180                    |
|  |   |  |                        |
|  |   |  |                        |
|  |   |  |                        |
|  |   |  | <del></del>            |
|  |   |  | <del></del> .          |
|  |   |  |                        |
|  |   |  |                        |
| If more than one screen, show location of each on sketc  | h   |  |                        |
|  | nay aid in locating the well  |  |                        |
| ketch the property layout and include the following:  1) the well location 2) any permanent structures on the property that m 3) any roads, power lines, or other items that may a   | nay aid in locating the well  | DEC DEC.   |                        |
| ketch the property layout and include the following:  1) the well location  2) any permanent structures on the property that m  3) any roads, power lines, or other items that may a  4) north arrow  SEE MAP  | nay aid in locating the well  | DE CONTRACTOR OF THE PARTY OF T |                        |
| 2) any permanent structures on the property that m 3) any roads, power lines, or other items that may a 4) north arrow  SEE MAP  ATTACTEL  Andowner Name: Mike BART  | lay aid in locating the well aid in locating the property and the well        | DFC S  |                        |
| ketch the property layout and include the following:  1) the well location  2) any permanent structures on the property that m  3) any roads, power lines, or other items that may a  4) north arrow  SEE MAP  ATTACTEL  HEREBY CERTIFY that the well/borehole was drill requirements of the Mississippi Department of Envergence of the M | led, constructed, and completed in accorda                                    | ince with all appliartment of Health   | icable<br>regulations, |
| Andowner Name:  Mike Manual Ma | led, constructed, and completed in accorda                                    | ince with all appliantment of Health   | icable<br>regulations, |

# STATE WELL REPORT

# PANOIA Permit #: Driller: Ratliff Water Well Service \_ Date completed:

## Part 2


Pump Installer's Completion Report Mississippi Department of Environmental Quality Office of Land and Water Resources P.O. Box 2309

| For Office Use Only: |
|----------------------|
| Well #:              |
| Aquifer:             |

|   | n, MS 39225-2309 Aquiter:   Aquiter:   |  |  |  |  |
|---|--|--|--|--|--|
|   | ) 360-0535 (fax)   |  |  |  |  |
|   |  |  |  |  |  |
| of the report must be attached and both parts filed with the D  | well contractor or a licensed pump installer. A copy of Part 1 epartment at the above address within 30 days of well completion. |  |  |  |  |
| Well Owner Information  | Well Location  |  |  |  |  |
| Owner Name: Mike BARHett  | Latitude: Longitude:   |  |  |  |  |
| Mailing Address: 1513 Hour Statte Rd  | Method of Lat/Long (check one): Conventional Survey,   |  |  |  |  |
|   | USGS quad, Hand-held GPS, Survey-grade GPS   |  |  |  |  |
| Como 15. 38619 City State Zip Code  | 1/4 1/4 Sec 6 T 75 R 64  |  |  |  |  |
| City State Zip Code   | Holles EAST of Couo US.  (Distance) (Direction) (Nearest Town)   |  |  |  |  |
| Telephone No. ()  | (Distance) (Direction) (Nearest Town)  |  |  |  |  |
|   | pe (circle one)  |  |  |  |  |
|   | ,  |  |  |  |  |
| Submersible Turbine Air Lift Centrifugal Flowing Well   |  |  |  |  |  |
| Date Pump Installed: 11-16-15 Rated Pump Capacity: _  | Gallons Per Minute   |  |  |  |  |
| Is This Pump (circle one): New Repaired Replacemen  |  |  |  |  |  |
| Power Type (circle one)   |  |  |  |  |  |
| Electric Diesel Gasoline Natural Gas Tractor PTO Wind   | dmill Other (describe):  |  |  |  |  |
| Horse Power Rating of Motor: 3 Setting Depth: 120 feet Number of Stages: 18   |  |  |  |  |  |
| Pump Test Data for Non Flowing Well   |  |  |  |  |  |
| Date Well Tested: 1/- 16 - 15 Duration of Pump Test (minimum 4 hours): 4 4 hours  |  |  |  |  |  |
| Static Water Level (A): $74$ Feet Below Land Surface  | Pumping Water Level (B): 105 Feet Below Land Surface   |  |  |  |  |
| Drawdown [(B) - (A)]: Feet Below Land Surface Test Pumping Rate: Gallons Per Minute   |  |  |  |  |  |
| Method of measurement (circle one): Steel tape Electric ta  | pe Air line Other (describe):  |  |  |  |  |
| Pump Test Data for Flowing Well   |  |  |  |  |  |
| Measured shut in head:xxfeet.   |  |  |  |  |  |
| Well yieldedGPM with a drawdown of  | feet after by hours of pumping   |  |  |  |  |
|   |  |  |  |  |  |
|   | nstallation  |  |  |  |  |
| Meter Manufacturer:xx   |  |  |  |  |  |
| Meter Model Number/Name:xx Type of Meter: xx  |  |  |  |  |  |
| Totalizer Register Unit and Multiplier Factor (AF x .001, gal x 1000, etc): xx  |  |  |  |  |  |
| Installation Date: xx Meter installed by: xx  |  |  |  |  |  |
| Is This Meter (circle one): New Repaired Replacement  |  |  |  |  |  |
| Important: By submitting the above information you are certifying that this meter was installed to manufacturer standards.  For agricultural wells, a list of approved meters is on the MDEQ website. |  |  |  |  |  |
| I HEREBY CERTIFY that the above statements are true to the best of my knowledge   |  |  |  |  |  |
|   | hast of my knowledget  |  |  |  |  |

11-24-15 Robert & Katta

Signature of Pump III Robert E. Ratliff 0-002 Print Name of Pump Installer and License No. (if applicable)

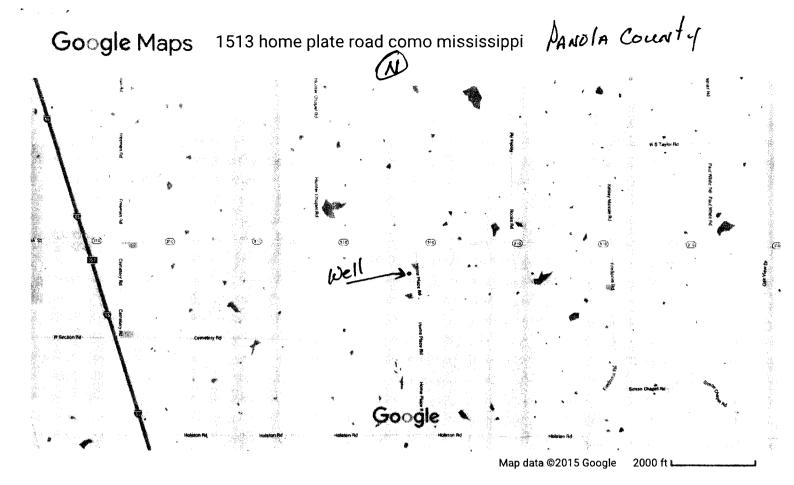

## We could not find 1513 home plate road como mississippi

Make sure your search is spelled correctly. Try adding a city, state, or zip code.

Add 1513 home plate road como mississippi to Google Maps.

More Google search results for 1513 home plate road como mississippi

