

Parola
H 2001
11-11-75

MISSISSIPPI
 BOARD OF WATER COMMISSIONERS
 416 North State Street
 Jackson, Mississippi 39201

DEC - 2, 1975
 MISS. BD. OF WATER COMMISSIONERS


WATER WELL DRILLERS LOG

11-11 1975 4 ipc well Co. Parola
 date well completed firm name county well located

LANDOWNER:	description of formations encountered	from	to
<u>D. R. HOPPS</u> <u>Como Miss.</u> (mailing address)			
	<u>Clay</u>	<u>20</u>	<u>40</u>
	<u>sand and clay</u>	<u>40</u>	<u>60</u>
	<u>Sand</u>	<u>60</u>	<u>91</u>
WELL LOCATION:			
sec. <u>7</u> T. <u>2</u> N. R. <u>6</u> E. ^{15E} <u>8</u> miles <u>East</u> of <u>COMO</u> (distance) (direction) (nearest town)			
WELL PURPOSE: (home, irrigation, municipal, industrial)			
WELL COMPLETION DATA:			
(1) diameter (inches) <u>4</u>			
(2) total depth (feet) <u>91</u>			
(3) static water level (feet) <u>30</u> below above top of ground.			
(4) casing <u>PVC</u> , <u>81</u> (material) (depth) <u>4</u> if telescope see back. (size)			
(5) screen <u>10</u> , <u>81</u> (length) (depth to top) <u>4</u> , <u>PVC</u> (size) (material)			
(6) pump <u>3/4</u> , <u>10</u> (HP) (yield gpm) <u>elec</u> (type power)			
(7) electric log <u>NO</u> (yes or no) <u>NO</u> (organization running log)			
(8) how well bottom plugged <u>PVC</u> <u>PLUS</u>			
DRILLERS REMARKS:			

If well telescopes please sketch and show depths.

GROUND LEVEL

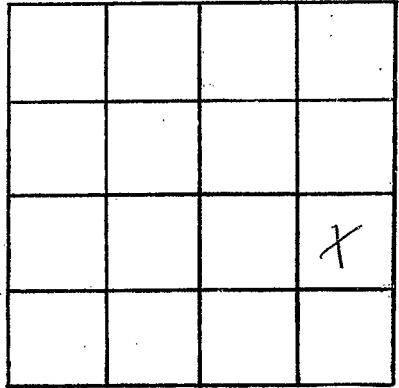

SECTION 2

Please indicate well location X.

ADDITIONAL INFORMATION

If more than one screen, show locations of each on sketch.