

Panola
H 2002
12-2-75

MISSISSIPPI
 BOARD OF WATER COMMISSIONERS
 416 North State Street
 Jackson, Mississippi 39201

WATER WELL DRILLERS LOG

12-2-75 date well completed HICKS Well CO. firm name Panola county well located

LANDOWNER: Woodie Poytee
RT-1
COMB MISS
 (mailing address)

WELL LOCATION:
 sec. 4 T. 7 N. R. 6 E.
6 miles EAST of COMO
 (distance) (direction) (nearest town)

WELL PURPOSE:
 (home, irrigation, municipal, industrial)

- WELL COMPLETION DATA:
- (1) diameter (inches) 4"
 - (2) total depth (feet) 230
 - (3) static water level (feet) 130 below/above top of ground.
 - (4) casing PVC, 230,
 (material) (depth)
 (size) if telescope see back.
 - (5) screen 7", 285
 (length) (depth to top)
1/2", INSIDE GRAVEL
 (size) (material)
 - (6) pump 1/2, 5
 (HP) (yield gpm)
220 EHP
 (type power)
 - (7) electric log (yes or no) _____
 (organization running log) _____
 - (8) how well bottom plugged CAP

description of formations encountered	from	to
Red clay	0	65
small gravel	65	80
White sand	80	95
White sand & clay	95	180
ROCK	180	182
White clay & sand	182	230
Black clay	230	230


DRILLERS REMARKS: Set STRAINER AT 180

DEC 22 1975

30. DAY WINTER

If well telescopes please sketch and show depths.

GROUND LEVEL

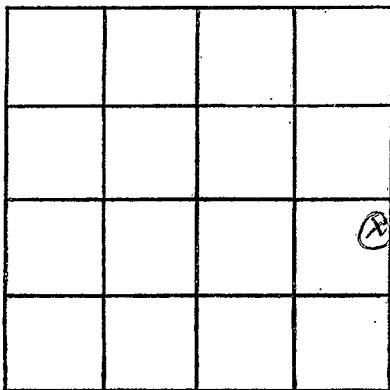

SECTION _____

Please indicate well location X.

ADDITIONAL INFORMATION

If more than one screen,
show locations of each on sketch.