

**PANOLA**  
**H 2004**  
**4-16-76**

MISSISSIPPI  
 BOARD OF WATER COMMISSIONERS  
 416 North State Street  
 Jackson, Mississippi 39201


WATER WELL DRILLERS LOG

4-16 1976 No Hicks Well Co. PANOLA  
 date well completed firm name county well located

LANDOWNER: <u>Simon Hunter</u>	description of formations encountered	from	to
Rt. 1 Como, Miss. (mailing address)	RED CLAY	0	10
	RED SAND	10	40
	GRAVEL	40	95
	WHITE SAND	95	145
<b>WELL LOCATION:</b> sec. <u>6</u> T. <u>2</u> N. R. <u>6</u> E <u>7</u> miles <u>E</u> of <u>COMO</u> (distance) (direction) (nearest town)			
<b>WELL PURPOSE:</b> <u>Home</u> (home, irrigation, municipal, industrial)			
<b>WELL COMPLETION DATA:</b>			
(1) diameter (inches) <u>4"</u>			
(2) total depth (feet) <u>145</u>			
(3) static water level (feet) <u>120</u> below above top of ground.			
(4) casing <u>PVC</u> , <u>138</u> (material) (depth)			
(size) If telescope see back.			
(5) screen <u>7'</u> <u>7'</u> (length) (depth to top)			
<u>4"</u> <u>INSIDE GRAVEL</u> (size) (material)			
(6) pump <u>1/2</u> <u>70</u> (HP) (yield gpm)			
<u>220</u> (type power)			
(7) electric log <u>No</u> (yes or no)			
(organization running log)			
(8) how well bottom plugged <u>CAP</u>			
<b>DRILLERS REMARKS:</b>			

If well telescopes please sketch and show depths.

GROUND LEVEL

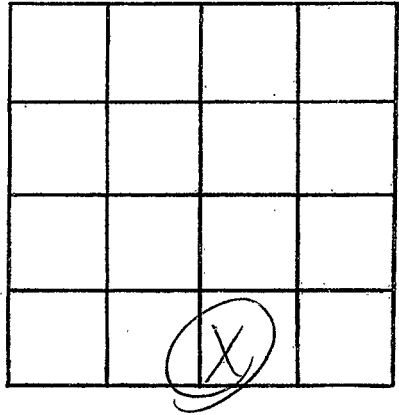

SECTION \_\_\_\_\_

Please indicate well location X.

ADDITIONAL INFORMATION

If more than one screen,  
show locations of each on sketch.