

PANOLA
H 2005
4/19/76

MISSISSIPPI
BOARD OF WATER COMMISSIONERS
416 North State Street
15E Jackson, Mississippi 39201

WATER WELL DRILLERS LOG

4-19

1976 Hicks Well Co

Panola

date well completed

firm name

county well located

LANDOWNER: Robert Ford

description of formations encountered

from

to

Rt. 1

Como, Miss.

(mailing address)

RED CLAY

-0

10

RED SAND & CLAY

10

30

WHITE SAND

130

170

Rock

170

192

BLACK CLAY

172

200

WELL LOCATION:

sec. 4 T. 17 N. R. 6 E. S. 1 W. 1
4 miles E of Como
(distance) (direction) (nearest town)

WELL PURPOSE: Home
(home, irrigation, municipal, industrial)

WELL COMPLETION DATA:

- (1) diameter (inches) 4"
- (2) total depth (feet) 200
- (3) static water level (feet) 135 below top of ground.
- (4) casing PVC, 200 (material) (depth)

(size) if telescope see back.

- (5) screen 12' 12' (length) (depth to top)
- 4" Inside GRAVEL (size) (material)

- (6) pump 1/2 10 (HP) (yield gpm)


220 (type power)

- (7) electric log No (yes or no)

(organization running log)

- (8) how well bottom plugged GRAVEL & Sand Bottom


DRILLERS REMARKS:

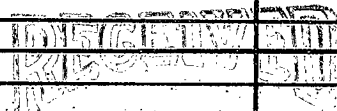

MAY 20 1976

If well telescopes please sketch and show depths.

GROUND LEVEL

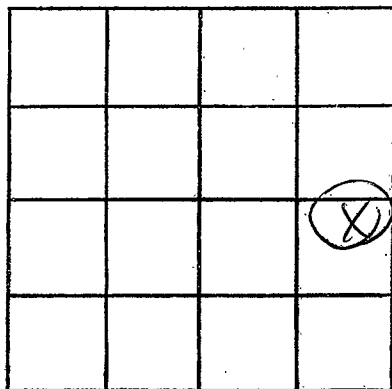

SECTION _____

Please indicate well location X.

ADDITIONAL INFORMATION

If more than one screen, show locations of each on sketch.