

Panola  
H 2006  
7/27/76

MISSISSIPPI  
 BOARD OF WATER COMMISSIONERS  
 416 North State Street  
 Jackson, Mississippi 39201

WATER WELL DRILLERS LOG

7-27 1976 Hecks Well Co. Panola  
 date well completed firm name county well located

LANDOWNER: Curtis Van Rook  
202 Valley Street  
Holly Springs, Miss  
 (mailing address)

| description of formations encountered | from       | to         |
|---------------------------------------|------------|------------|
| <u>Red Sand + Clay</u>                | <u>0</u>   | <u>50</u>  |
| <u>White Sand + Clay</u>              | <u>50</u>  | <u>130</u> |
| <u>Black Clay + Sand</u>              | <u>130</u> | <u>240</u> |
| <u>White Sand</u>                     | <u>240</u> | <u>275</u> |

WELL LOCATION:  
 sec. 47 N 6 E  
 (S) (W)  
6 miles E of Coma  
 (distance) (direction) (nearest town)

WELL PURPOSE: Home  
 (home, irrigation, municipal, industrial)

- WELL COMPLETION DATA:
- (1) diameter (inches) 4"
  - (2) total depth (feet) 275'
  - (3) static water level (feet) 120 below above top of ground.
  - (4) casing PVC, 275'  
 (material) (depth)  
 (size) If telescope see back.
  - (5) screen 7', 26'  
 (length) (depth to top)  
4" gravel  
 (size) (material)
  - (6) pump 1/2 10gal.  
 (HP) (yield/gpm)  
220V  
 (type power)
  - (7) electric log NO  
 (yes or no)

(organization running log)

(8) how well bottom plugged cap


DRILLERS REMARKS:

**RECEIVED**  
 AUG 26 1976

MISS. BD. OF WATER COMMISSIONERS

If well telescopes please sketch and show depths.

GROUND LEVEL

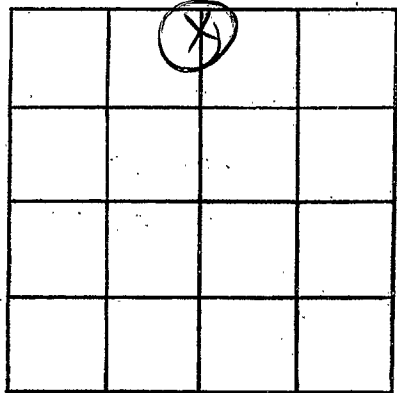

SECTION 4

Please indicate well location X.

ADDITIONAL INFORMATION

If more than one screen,  
show locations of each on sketch.