

Panola
H 2007
9-6-79

MISSISSIPPI
 BOARD OF WATER COMMISSIONERS
 416 North State Street
 Jackson, Mississippi 39201

WATER WELL DRILLERS LOG

9-6 19 79 Heels Wells Panola
 date well completed firm name county well located

LANDOWNER:
Bill Graham
3620 Inman Drive
 (mailing address)

description of formations encountered	from	to
<u>Red Clay</u>	<u>0</u>	<u>30</u>
<u>Gravel</u>	<u>30</u>	<u>60</u>
<u>White Clay</u>	<u>60</u>	<u>100</u>
<u>White Sand</u>	<u>100</u>	<u>120</u>

WELL LOCATION:
 sec. 32 T 1 N R. 6 E
4 miles E of Sardis
 (distance) (direction) (nearest town)

WELL PURPOSE: home
 (home, irrigation, municipal, industrial)

WELL COMPLETION DATA:
 (1) diameter (inches) 4 in
 (2) total depth (feet) 120
 (3) static water level (feet) _____ below above top of ground.
 (4) casing Plastic 120
 (material) (depth)
 _____ if telescope see back.
 (size)
 (5) screen 20 ft 163
 (length) (depth to top)
4 in Gravel
 (size) (material)
 (6) pump 1/2 10
 (HP) (yield gpm)
220
 (type power)
 (7) electric log No
 (yes or no)

 (organization running log)
 (8) how well bottom plugged cap

Miss. Board of Water Comm.


SEP 11 1979

RECEIVED

DRILLERS REMARKS:

If well telescopes please sketch and show depths.

GROUND LEVEL

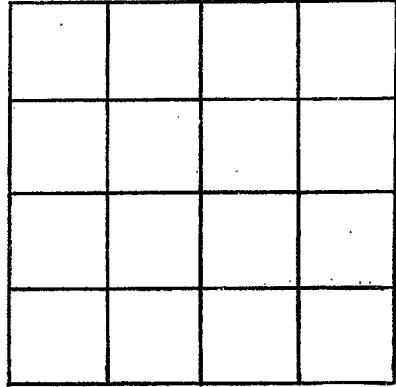

SECTION _____

Please indicate well location X.

ADDITIONAL INFORMATION

If more than one screen, show locations of each on sketch.