

Panola
H 2008
11-27-79

MISSISSIPPI
 BOARD OF WATER COMMISSIONERS
 416 North State Street
 Jackson, Mississippi 39201

WATER WELL DRILLERS LOG

11-27 19 79 Hecht Well Co. Panola
 date well completed firm name county well located

LANDOWNER:	description of formations encountered	from	to
<u>Clara Lagan Dean</u> <u>Rt. 1, Box 426, Sardis Miss</u> (mailing address)			
WELL LOCATION:	<u>red clay</u>	<u>30</u>	<u>70</u>
sec. <u>8</u> T. <u>7</u> N. R. <u>6</u> E <u>3</u> miles <u>S</u> of <u>310 high</u> (distance) (direction) (nearest town)	<u>white sand</u>	<u>70</u>	<u>150</u>
WELL PURPOSE: <u>home</u> (home, irrigation, municipal, industrial)	<u>black clay</u>	<u>150</u>	<u>170</u>
WELL COMPLETION DATA:			
(1) diameter (inches) <u>4 in</u>			
(2) total depth (feet) <u>170</u>			
(3) static water level (feet) <u>120</u> below top of ground.			
(4) casing <u>Plastic</u> <u>170</u> (material) (depth)			
(size) if telescope see back.			
(5) screen <u>7 ft</u> <u>163</u> (length) (depth to top)			
<u>4 in</u> <u>brass</u> (size) (material)			
(6) pump <u>1/2</u> <u>10</u> (HP) (yield gpm)			
<u>220</u> (type power)			
(7) electric log <u>No</u> (yes or no)			
(organization running log)			
(8) how well bottom plugged <u>Cap</u>			
DRILLERS REMARKS:			


DEPT. OF NATURAL RESOURCES
 BUREAU OF LAND & WATER RESOURCES

DEC 0 1979

RECEIVED

If well telescopes please sketch and show depths.

GROUND LEVEL

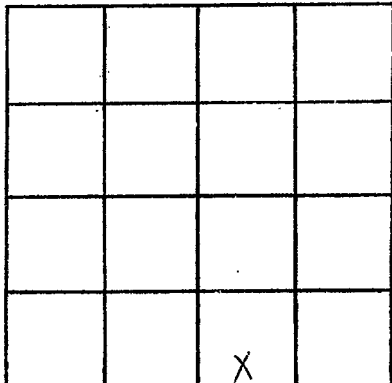

SECTION 8

Please indicate well location X.

ADDITIONAL INFORMATION

A series of horizontal lines for writing additional information.

If more than one screen, show locations of each on sketch.