

PANOLA
 H 2009
 9-15-80

MISSISSIPPI
 BOARD OF WATER COMMISSIONERS
 416 North State Street
 Jackson, Mississippi 39201

WATER WELL DRILLERS LOG

9-15 1980 Hick Well Co Panola
 date well completed firm name county well located

LANDOWNER: <u>Quincy Kendrick</u> <u>(Pt.)</u> <u>Como, Ms.</u> (mailing address)	description of formations encountered	from	to
	<u>Red clay</u>	<u>0</u>	<u>20</u>
	<u>white sand</u>	<u>20</u>	<u>110</u>
	<u>Rock</u>	<u>110</u>	<u>112</u>
	<u>Black Clay</u>	<u>112</u>	<u>180</u>
	<u>white sand</u>	<u>180</u>	<u>220</u>

WELL LOCATION:

sec. 8 T. 17 N. R. 6 E.
3 miles SW of Stevinsville
 (distance) (direction) (nearest town)

WELL PURPOSE: none
 (home, irrigation, municipal, industrial)

WELL COMPLETION DATA:

- (1) diameter (inches) 4
- (2) total depth (feet) 220
- (3) static water level (feet) 110 below top of ground.
- (4) casing PVC, 220
 (material) (depth)
 (size) If telescope see back.
- (5) screen 71, 213
 (length) (depth to top)
4" gravel Tapco
 (size) (material)
- (6) pump 3/4, 10
 (HP) (yield gpm)
220V
 (type power)
- (7) electric log No.
 (yes or no)

(organization running log)

(8) how well bottom plugged Cop

DRILLERS REMARKS:


DEPT. OF NATURAL RESOURCES
 BUREAU OF LAND & WATER RESOURCES

SEP 29 1980

RECEIVED

If well telescopes please sketch and show depths.

GROUND LEVEL

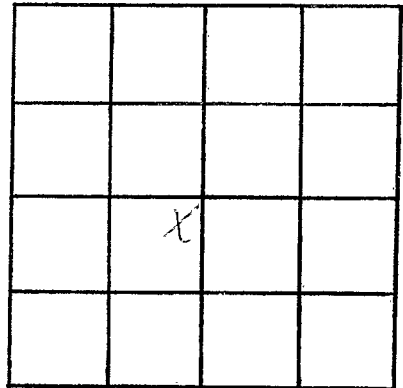

SECTION 8

Please indicate well location X.

ADDITIONAL INFORMATION

If more than one screen,
show locations of each on sketch.