

MISSISSIPPI DEPARTMENT OF NATURAL RESOURCES

Bureau of Land and Water Resources

Southport Mall

P.O. Box 10631

Jackson, Mississippi 39209

WATER WELL DRILLERS LOG

PANDLA
H 2010
1-27-81

1-27 1981
date well completed

Hicks Well Co.
firm name

Pandla
county well located

LANDOWNER: Liberty Hill Church

description of formations encountered

from

to

BT. 1

Caro, Ms.
(mailing address)

Red Sand 0 50
White Clay 50 130

WELL LOCATION:

sec. 4 T 17 N R 6 E
6 miles E of Caro
(distance) (direction) (nearest town)

Rock 130 132
Blue Clay 132 160

WELL PURPOSE: Church
(home, irrigation, municipal, industrial)

Rock 160 162
Clay 162 170

WELL COMPLETION DATA:

- (1) diameter (inches) 4
- (2) total depth (feet) 215
- (3) static water level (feet) 140 below top of ground.
- (4) casing PVC 215.
(material) (depth)

Clay & Sand 170 215

— if telescope see back.
(size)

- (5) screen 1.0 2.05
(length) (depth to top)

2 1/2" Slotted
(size) (material)

- (6) pump 1/2 10
(HP) (yield gpm)

220V
(type power)

- (7) electric log No
(yes or no)

(organization running log)

- (8) how well bottom plugged Cap

DRILLERS REMARKS:


DEPT. OF NATURAL RESOURCES
BUREAU OF LAND & WATER RESOURCES

FEB 12 1981

RECEIVED

If well telescopes please sketch and show depths.

GROUND LEVEL

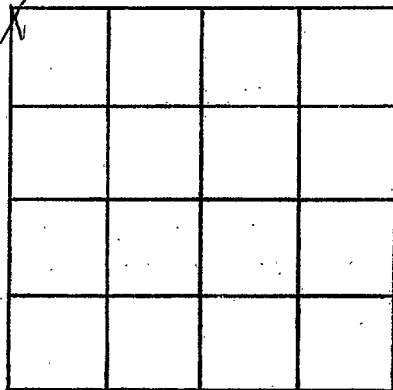

SECTION 4

Please indicate well location X.

ADDITIONAL INFORMATION

If more than one screen, show locations of each on sketch.