

MISSISSIPPI DEPARTMENT OF NATURAL RESOURCES

Bureau of Land and Water Resources

Southport Mall

P.O. Box 10631

Jackson, Mississippi 39209

WATER WELL DRILLERS LOG

Parola
H 2011

4-7-82
date well completed

Bruce Smith
firm name

Parola
county well located

LANDOWNER:	description of formations encountered	from	to
<u>Genl. Williams</u> <u>Como, Miss.</u> (mailing address)			
	<u>red clay</u>	<u>5</u>	<u>29</u>
	<u>gravel</u>	<u>29</u>	<u>42</u>
	<u>white clay</u>	<u>42</u>	<u>130</u>
	<u>sand</u>	<u>130</u>	<u>205</u>

WELL LOCATION:
sec. 3 T 7 N R 6 E
7 miles E of Como
(distance) (direction) (nearest town)

WELL PURPOSE:
(home) irrigation, municipal, industrial

- WELL COMPLETION DATA:
- (1) diameter (inches) 4"
 - (2) total depth (feet) 205'
 - (3) static water level (feet) 150' below above top of ground.
 - (4) casing plastic 205'
(material) (depth)
if telescope see back.
(size)
 - (5) screen 20' 195'
(length) (depth to top)
4" plastic
(size) (material)
 - (6) pump 1/2 10
(HP) (yield gpm)
elec.
(type power)
 - (7) electric log (yes or no)
(organization running log)
 - (8) how well bottom plugged Cap

DRILLERS REMARKS:


DEPT. OF NATURAL RESOURCES
BUREAU OF LAND & WATER RESOURCES

OCT 12 1982

RECEIVED

If well telescopes please sketch and show depths.

GROUND LEVEL

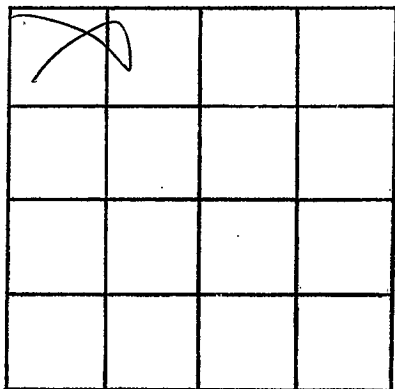

SECTION _____

Please indicate well location X.

ADDITIONAL INFORMATION

If more than one screen,
show locations of each on sketch.