

MISSISSIPPI DEPARTMENT OF NATURAL RESOURCES

Bureau of Land and Water Resources

Southport Mall

P.O. Box 10631

Jackson, Mississippi 39209

WATER WELL DRILLERS LOG

Panola
H
2012

LUCKS WELL CO.
 film name X 137
 No. 27 100 20668

Panola
 county well located

9-19 19*84*
 date well completed

LANDOWNER: *Mike Bartlett*

description of formations encountered	from	to

Rt. 1
Cono, Ms. 38619
 (mailing address)

<i>Red Clay</i>	<i>0</i>	<i>10</i>
<i>Red Sand</i>	<i>10</i>	<i>60</i>

WELL LOCATION:
 sec. *20* T *7* N R *6* E
6 miles *E* of *Cono*
 (distance) (direction) (nearest town)

<i>White Sand + Clay</i>	<i>60</i>	<i>180</i>
<i>White Sand</i>	<i>180</i>	<i>215</i>

WELL PURPOSE: *Home*
 (home, irrigation, municipal, industrial)

WELL COMPLETION DATA:

- (1) diameter (inches) *4*
- (2) total depth (feet) *215*
- (3) static water level (feet) *180* ^{below} _{above} top of ground.
- (4) casing *PVC*, *215*
 (material) (depth)
4"
 (size) if telescope see back.
- (5) screen *10'*, *205*
 (length) (depth to top)
1.010, *PVC*
 (size) (material)
- (6) pump *3/4*, *10*
 (HP) (yield gpm)
2200
 (type power)
- (7) electric log *No*
 (yes or no)

(organization running log)

(8) how well bottom plugged *Cap*

DRILLERS REMARKS:


DEPT. OF NATURAL RESOURCES
 BUREAU OF LAND & WATER RESOURCES

SEP 24 1984

RECEIVED

If well telescopes please sketch and show depths.

GROUND LEVEL

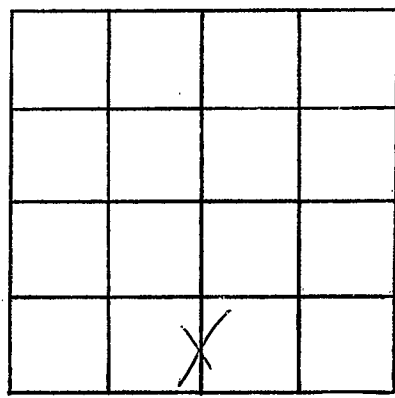

SECTION 20

Please indicate well location X.

ADDITIONAL INFORMATION

Lined area for additional information.

If more than one screen, show locations of each on sketch.