

MISSISSIPPI DEPARTMENT OF NATURAL RESOURCES

Bureau of Land and Water Resources

Southport Mall

P.O. Box 10631

Jackson, Mississippi 39209

WATER WELL DRILLERS LOG

H 2013
 PANOLA

1-19-85 date well completed
 HICKS WELL CO.
 well name 157

Panola county well located

LANDOWNER: METHANEY RANCH
 Bt. 1
 Com. Ms. 3 0619
 (mailing address)

description of formations encountered	from	to
Red Clay	0	10
Red sand	10	40

WELL LOCATION:
 sec. 9 T. 7 N. R. 6 E
 4 miles NE of Sardis
 (distance) (direction) (nearest town)

White Sand	40	215
------------	----	-----

WELL PURPOSE: Ranch
 (home, irrigation, municipal, industrial)

WELL COMPLETION DATA:

(1) diameter (inches) 4"
 (2) total depth (feet) 215
 (3) static water level (feet) 160 below top of ground.
 (4) casing PVC, 215 (depth)
 4" (size) If telescope see back.
 (5) screen 10 (length), 205 (depth to top)
 1/2" (size) PVC (material)
 (6) pump 1 (HP), 18 (yield gpm)
 220V (type power)
 (7) electric log No (yes or no)
 (organization running log)
 (8) how well bottom plugged CAP


RECEIVED
 MAR 14 1985

Department of Natural Resources
 Bureau of Land & Water Resources

DRILLERS REMARKS:

If well telescopes please sketch and show depths.

GROUND LEVEL

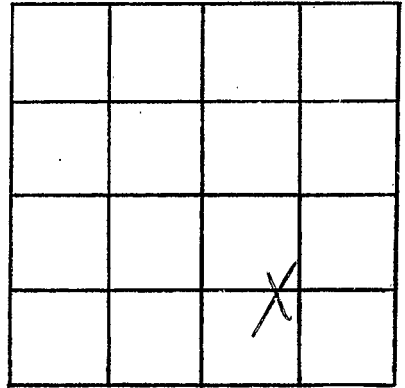

SECTION 9

Please indicate well location X.

ADDITIONAL INFORMATION

Lined area for additional information.

If more than one screen, show locations of each on sketch.