

MISSISSIPPI DEPARTMENT OF NATURAL RESOURCES

Bureau of Land and Water Resources

Southport Mall

P.O. Box 10631

Jackson, Mississippi 39209

WATER WELL DRILLERS LOG

HICKS WELL COMPANY

RT. 1 - BOX 157

SENATOBIA, MISS.

county well located

H 2014
Panola
10-15-85

6-15 19 *85*
 date well completed

Panola

LANDOWNER: *Charles Boyd Jr.*

description of formations encountered

from to

W # 1

Como MS 38619
 (mailing address)

Red clay

0 10

Red Sand

10 50

WELL LOCATION:

sec. *3* T. *7* N. R. *6* E.
5 miles *E* of *Como*
 (distance) (direction) (nearest town)

White Sand & clay

50 100

White Sand

100 125

WELL PURPOSE: *Home*
 (home, irrigation, municipal, industrial)

WELL COMPLETION DATA:

- (1) diameter (inches) *4"*
- (2) total depth (feet) *125*
- (3) static water level (feet) *120* ^{below} above top of ground.
- (4) casing *PVC*, *120*,
 (material) (depth)
4" If telescope see back.
 (size)
- (5) screen *15'*, *120*
 (length) (depth to top)
1/2", *PVC*
 (size) (material)
- (6) pump *3/4*, *10*
 (HP) (yield gpm)
220 V
 (type power)
- (7) electric log *NO*
 (yes or no)
 (organization running log)
- (8) how well bottom plugged *Cap*


RECEIVED
 SEP 20 1985

DRILLERS REMARKS:

Department of Natural Resources
 Bureau of Land & Water Resources

If well telescopes please sketch and show depths.

GROUND LEVEL

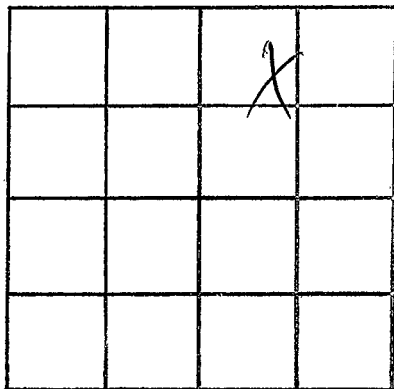

SECTION 3

Please indicate well location X.

ADDITIONAL INFORMATION

If more than one screen,
show locations of each on sketch.