

MISSISSIPPI DEPARTMENT OF NATURAL RESOURCES

Bureau of Land and Water Resources

Southport Mall

P.O. Box 10631

Jackson, Mississippi 39209

WATER WELL DRILLERS LOG

PANOLA
H 2015

HICKS WELL COMPANY

Panola

9-9 1985
date well completed

RT. 1 ~~Box 657~~

county well located

LANDOWNER: *Jerry Beck*

SENATOBIA, MISS.

description of formations encountered

from

to

Rt # 1

red clay

0

10

Como, MS 38619
(mailing address)

red sand

10

50

WELL LOCATION:

sec. 2 T 7 N R 6 E
S W
7 miles E of Como
(distance) (direction) (nearest town)

white clay + white sand

50

140

white sand

140

200

WELL PURPOSE: *Home*
(home, irrigation, municipal, industrial)

WELL COMPLETION DATA:

- (1) diameter (inches) 4"
- (2) total depth (feet) 200'
- (3) static water level (feet) 180' ^{below} above top of ground.

- (4) casing PVC 180'
(material) (depth)
4" if telescope see back.
(size)

- (5) screen 20' 180'
(length) (depth to top)
0/3 PVC
(size) (material)

- (6) pump 3/4 10
(HP) (yield gpm)
220 V
(type power)

- (7) electric log NO
(yes or no)

(organization running log)

- (8) how well bottom plugged Ccp


DRILLERS REMARKS:

RECEIVED
DEC 16 1985

Department of Natural Resources
Bureau of Land & Water Resources

If well telescopes please sketch and show depths.

GROUND LEVEL

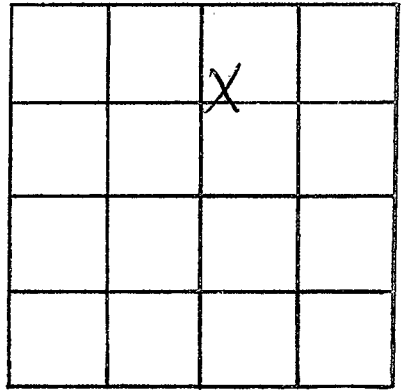

SECTION 2

Please indicate well location X.

ADDITIONAL INFORMATION

If more than one screen, show locations of each on sketch.