

MISSISSIPPI DEPARTMENT OF NATURAL RESOURCES

Bureau of Land and Water Resources

Southport Mall

P.O. Box 10631

Jackson, Mississippi 39209

WATER WELL DRILLERS LOG

PANOLA
H 2016

11-10 1984 date well completed
84 LIFE WELL & SUPPLY PANOLA firm name
county well located

LANDOWNER: CLAUD LATHAM
5763 BRENNERS, PL.
PARULET, TN 38134
(mailing address)

WELL LOCATION:
sec. 30 T 7 N R 6 E
S W
3 miles EAST of SARDIS
(distance) (direction) (nearest town)

WELL PURPOSE: HOME
(home, irrigation, municipal, industrial)

WELL COMPLETION DATA:

- (1) diameter (inches) 4
- (2) total depth (feet) 215
- (3) static water level (feet) 60 below top of ground.
- (4) casing PVC, 205'
(material) (depth)
 If telescope see back.
(size)
- (5) screen 10, 205
(length) (depth to top)
4", PVC-GRNVL
(size) (material)
- (6) pump 1 18
(HP) (yield gpm)
230 10
(type power)
- (7) electric log NO
(yes or no)
 (organization running log)
- (8) how well bottom plugged CAP

description of formations encountered	from	to
TOP SOIL	0	9
GRNVL	9	20
GRNVL	20	40
GRNVL	40	50
ROCK	50	51
CLAY	51	70
CLAY	70	90
CLAY	90	100
CLAY	100	120
CLAY w/ SAND	120	140
CLAY	140	160
CLAY	160	180
CLAY	180	199
SAND	199	200
SAND	200	217
CLAY	217	220

RECEIVED
RECEIVED
RECEIVED


JAN 19 1985

Department of Natural Resources
Bureau of Land & Water Resources

DRILLERS REMARKS:
2.0 MG/L FE

If well telescopes please sketch and show depths.

GROUND LEVEL

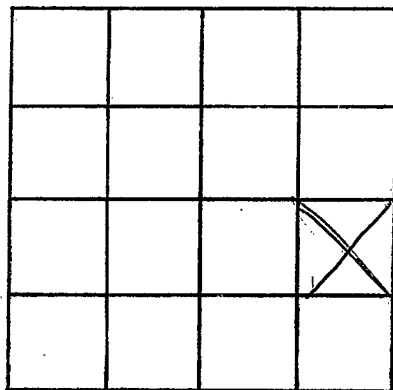

SECTION 30

Please indicate well location X.

ADDITIONAL INFORMATION

If more than one screen,
show locations of each on sketch.