


If well telescopes please
sketch and show depths.

GROUND LEVEL

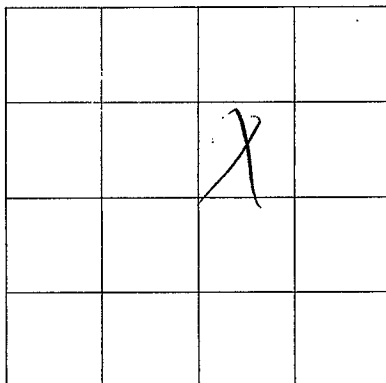

SECTION H

Please indicate well location X.

ADDITIONAL INFORMATION

If more than one screen,
show location of each on sketch.