

**MISSISSIPPI DEPARTMENT OF NATURAL RESOURCES**  
Bureau of Land and Water Resources

P.O. Box 10631  
Jackson, Mississippi 39209  
WATER WELL DRILLERS LOG

COUNTY WELL LOCATED <u>Panola</u>	
WELL NUMBER <u>H 2019</u>	CODED
DATE WELL COMPLETED <u>10-6-87</u>	

PERMIT NUMBER
NAME OF DRILLING FIRM <b>HICKS WELL COMPANY</b>
RT. 1 - BOX 157

NAME & MAILING ADDRESS OF LANDOWNER <u>Henry Hamilton</u> <u>328 Lincoln ST.</u> <u>Sardis, MS 38666</u>			
WELL LOCATION:	SEC	TOWNSHIP	RANGE
	<u>4</u>	<u>7</u>	<u>6</u>
		<u>N</u>	<u>E</u>
		<u>S</u>	<u>W</u>
DISTANCE	DIRECTION	NEAREST TOWN	
<u>3</u> Miles	<u>SE</u> of	<u>Como</u>	
OTHER LANDMARK			
WELL PURPOSE (Circle One) Irrigation, Municipal, Industrial, Fish Pond, etc. <u>Home</u>			


PUMP DATA		
PUMP TYPE (Circle One): <u>Submersible</u> , Turbine, Jet, Flowing Well, Other (Describe) _____		
POWER TYPE (Circle One): <u>Electric</u> , Tractor, Diesel, Gasoline, Butane, Other (Describe) _____		
Pump Capacity (GPM)	No. of Stages	Setting Depth
<u>10</u>	<u>7</u>	<u>120'</u> FT.
PUMP TEST		
Well yielded _____ GPM with a drawdown of _____ ft. after _____ hours of pumping		

WELL DATA		
Well Depth <u>185'</u>	Casing Diameter (In.) <u>4"</u>	Casing Length (Ft.) <u>175'</u>
Type of Casing <u>PVC</u>	Hole Depth <u>185'</u>	Depth to Static Water Level <u>100'</u>
TYPE OF COMPLETION: (Circle One or More): Gravel Packed, Underreamed, Telescoped, Natural Development, Open Hole, Other (Describe) <u>PVC cap</u>		
Top of Lap Pipe or Reduction in Casing <u>FEET</u> IF TELESCOPED OR MORE THAN ONE SCREEN: USE BACK PAGE		

LOG DATA	
TYPE OF LOG RUN (Circle One): Electric, Gamma Ray, Density, Sonic, Neutron, Other (Describe) _____	
Name of Organization Running Log	


SCREEN DATA		
Diameter - Inches <u>4"</u>	Length - Feet <u>10'</u>	Slot Size - Inches <u>.013</u>
Screen Type <u>PVC</u>	Depth to Bottom - Feet <u>185'</u>	

GEOLOGIC DATA (Office Use Only)			
Surface Elev.	Geologic Unit	Unit Thickness	Depth to Top
Subs. SWL	Date	Analysis	Aquifer Test
Driller's Remarks			

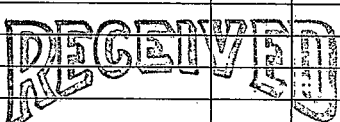DESCRIPTION OF FORMATIONS ENCOUNTERED	FROM	TO	FORMATIONS (Continued)	FROM	TO
<u>Red clay</u>	<u>0</u>	<u>15</u>	 <u>NOV 16 1987</u> Department of Natural Resources Bureau of Land & Water Resources		
<u>Red Sand &amp; Gravel</u>	<u>15</u>	<u>40</u>			
<u>White Sand &amp; White clay</u>	<u>40</u>	<u>80</u>			
<u>White Sand</u>	<u>80</u>	<u>185</u>			
IF MORE SPACE IS NEEDED, USE BACK					

If well telescopes please sketch and show depths.

GROUND LEVEL

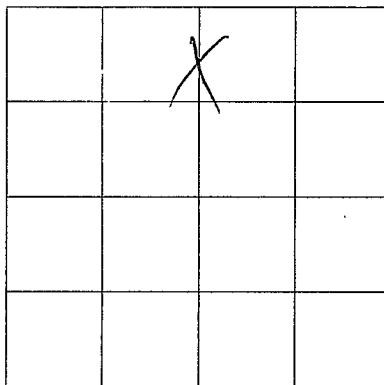

SECTION 47

Please indicate well location X.

ADDITIONAL INFORMATION

If more than one screen, show location of each on sketch.