

MISSISSIPPI DEPARTMENT OF ENVIRONMENTAL QUALITY
Bureau of Land and Water Resources

P. O. Box 10631
Jackson, MS 39289-0631
WATER WELL DRILLERS LOG

COUNTY WELL LOCATED <i>panola</i>	
WELL NUMBER <i>H 2027</i>	CODED
DATE WELL COMPLETED <i>8-12-92</i>	

PERMIT NUMBER
NAME OF DRILLING FIRM HICKS WELL CO.
RT. 1 BOX 157 SENATORIA, MS 39063

NAME & MAILING ADDRESS OF LANDOWNER <i>Edward Pidgeon</i>		
<i>P.O. 96</i>		
<i>COMO, MS.</i>		
WELL LOCATION: SEC	TOWNSHIP	RANGE
<i>3</i>	<i>7</i>	<i>N 6 W</i>
DISTANCE	DIRECTION	NEAREST TOWN
<i>8</i> Miles	<i>E</i>	of <i>COMO</i>
OTHER LANDMARK		
WELL PURPOSE: <input checked="" type="radio"/> Home Irrigation, Municipal, Industrial, Fish Pond, etc.		

PUMP DATA		
PUMP TYPE (Circle One): Submersible, Turbine, Jet, Flowing Well, Other (Describe) _____		
POWER TYPE (Circle One): Electric, Tractor, Diesel, Gasoline, Butane, Other (Describe) _____ H/P <i>1 1/2</i>		
Pump Capacity (GPM) <i>22</i>	No. of Stages <i>18 BC</i>	Setting Depth <i>180</i> FT.
PUMP TEST		
Well yielded _____ GPM with a drawdown of _____ ft. after _____ hours of pumping		

WELL DATA		
Well Depth <i>220</i>	Casing Diameter (In.) <i>4"</i>	Casing Length (Ft.) <i>220</i>
Type of Casing <i>PVC</i>	Hole Depth <i>220</i>	Depth to Static Water Level <i>140</i>
TYPE OF COMPLETION: (Circle One or More): <input checked="" type="radio"/> Gravel Packed, <input type="radio"/> Underreamed, <input type="radio"/> Telescoped, <input type="radio"/> Natural Development, <input type="radio"/> Open Hole, <input type="radio"/> Other		
Top of Lap Pipe or Reduction in Casing FEET <input type="checkbox"/> IF TELESCOPED OR MORE THAN ONE SCREEN: USE BACK PAGE		

LOG DATA	
TYPE OF LOG RUN (Circle One): No Log Run, Electric, Gamma Ray, Density, Sonic, Neutron, Other (Describe) _____	
Name of Organization Running Log	


SCREEN DATA		
Diameter - Inches <i>4"</i>	Length - Feet <i>10'</i>	Slot Size - Inches <i>013</i>
Screen Type <i>PVC</i>		Depth to Bottom - Feet <i>10'</i>

GEOLOGIC DATA (Office Use Only)			
Surface Elev.	Geologic Unit	Unit Thickness	Depth to Top
Subs. SWL	Date	Analysis	Aquifer Test
Driller's Remarks			

DESCRIPTION OF FORMATIONS ENCOUNTERED	FROM	TO	FORMATIONS ENCOUNTERED	FROM	TO
<i>R/S</i>	<i>0</i>	<i>40</i>	DISCOVERED	FROM	TO
<i>Gravel</i>	<i>40</i>	<i>80</i>			
<i>Clay</i>	<i>80</i>	<i>160</i>			
<i>W.S.</i>	<i>160</i>	<i>220</i>			
OCT 22 1992					
Dept. of Environmental Quality Bureau of Land & Water Resources					
IF MORE SPACE IS NEEDED, USE BACK					

If well telescopes please
sketch and show depths.

GROUND LEVEL

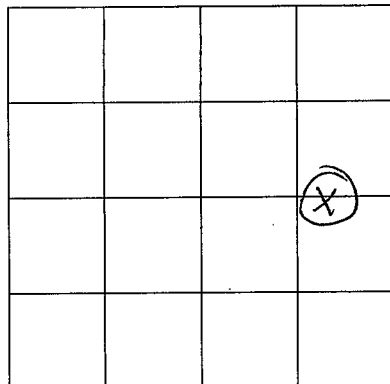

SECTION _____

Please indicate well location X.

ADDITIONAL INFORMATION

If more than one screen,
show location of each on sketch.